


# DISTANCES IN COMMERCIAL AVENUE

2  
4  
John C. Moore Corporation, Rochester, N. Y. Binder and holes in leaves, each Patented 1906.

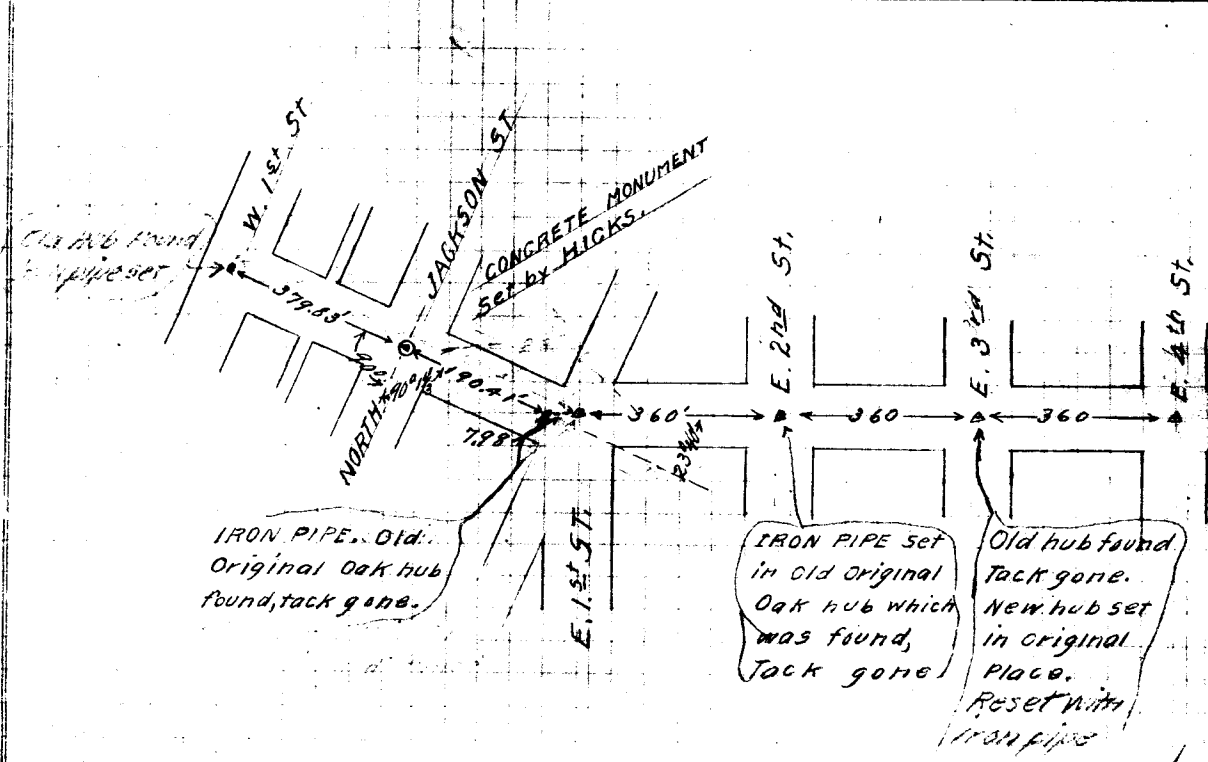

C. S. File No. 25/17