


100

SKETCH OF PROPOSED PRIVATE SEWER. Not drawn to scale.

WOODWARD STREET.

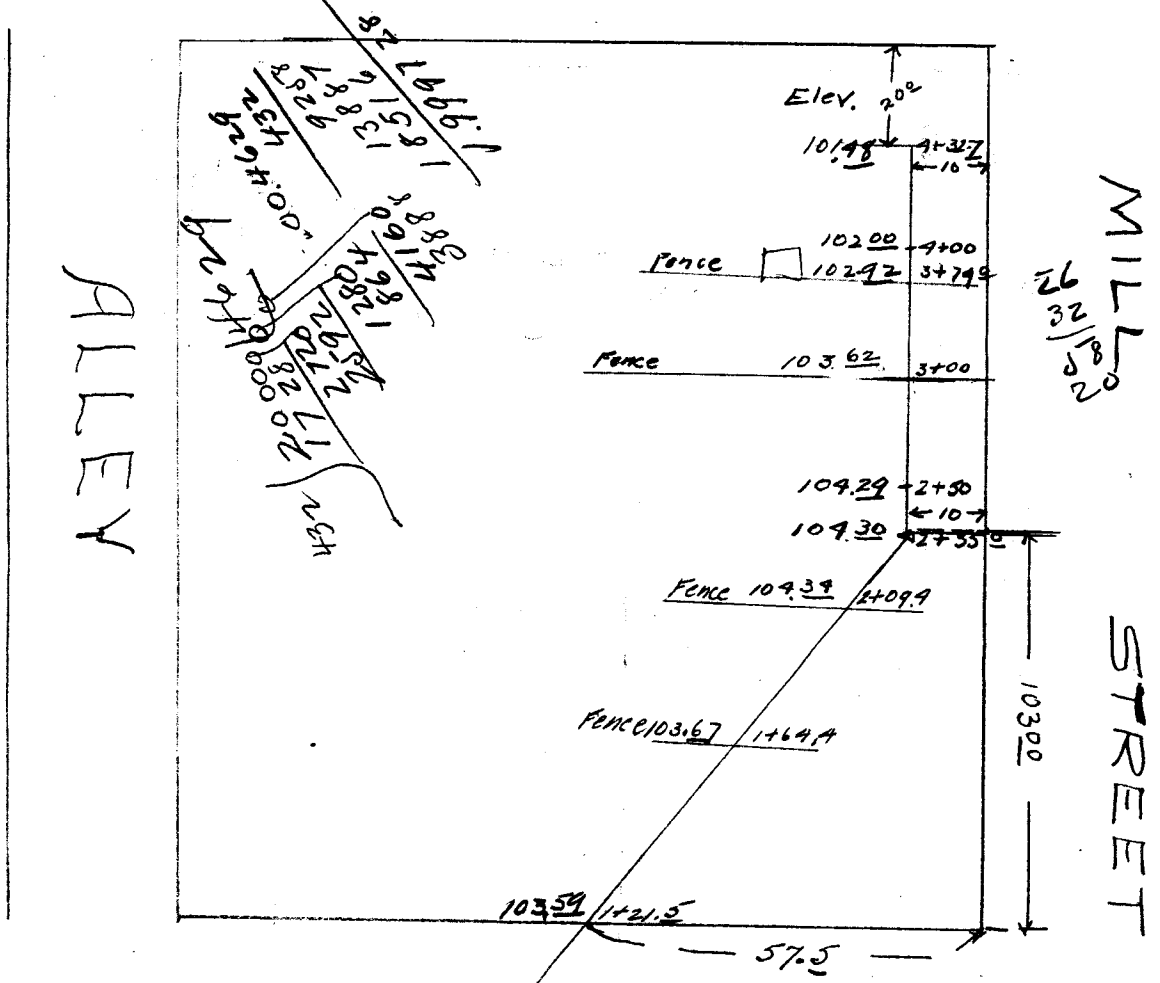

FLOED STREET.

