


PLAN OF SEWER SYSTEM FOR EAST LANE STREET DISTRICT. ROSEBURG ORE.

○ Manhole
 ● Lamphole
 — Intended lines.
 - - - - - lines const.

L. G. Hicks
 CITY ENGINEER.

JAN 1917.

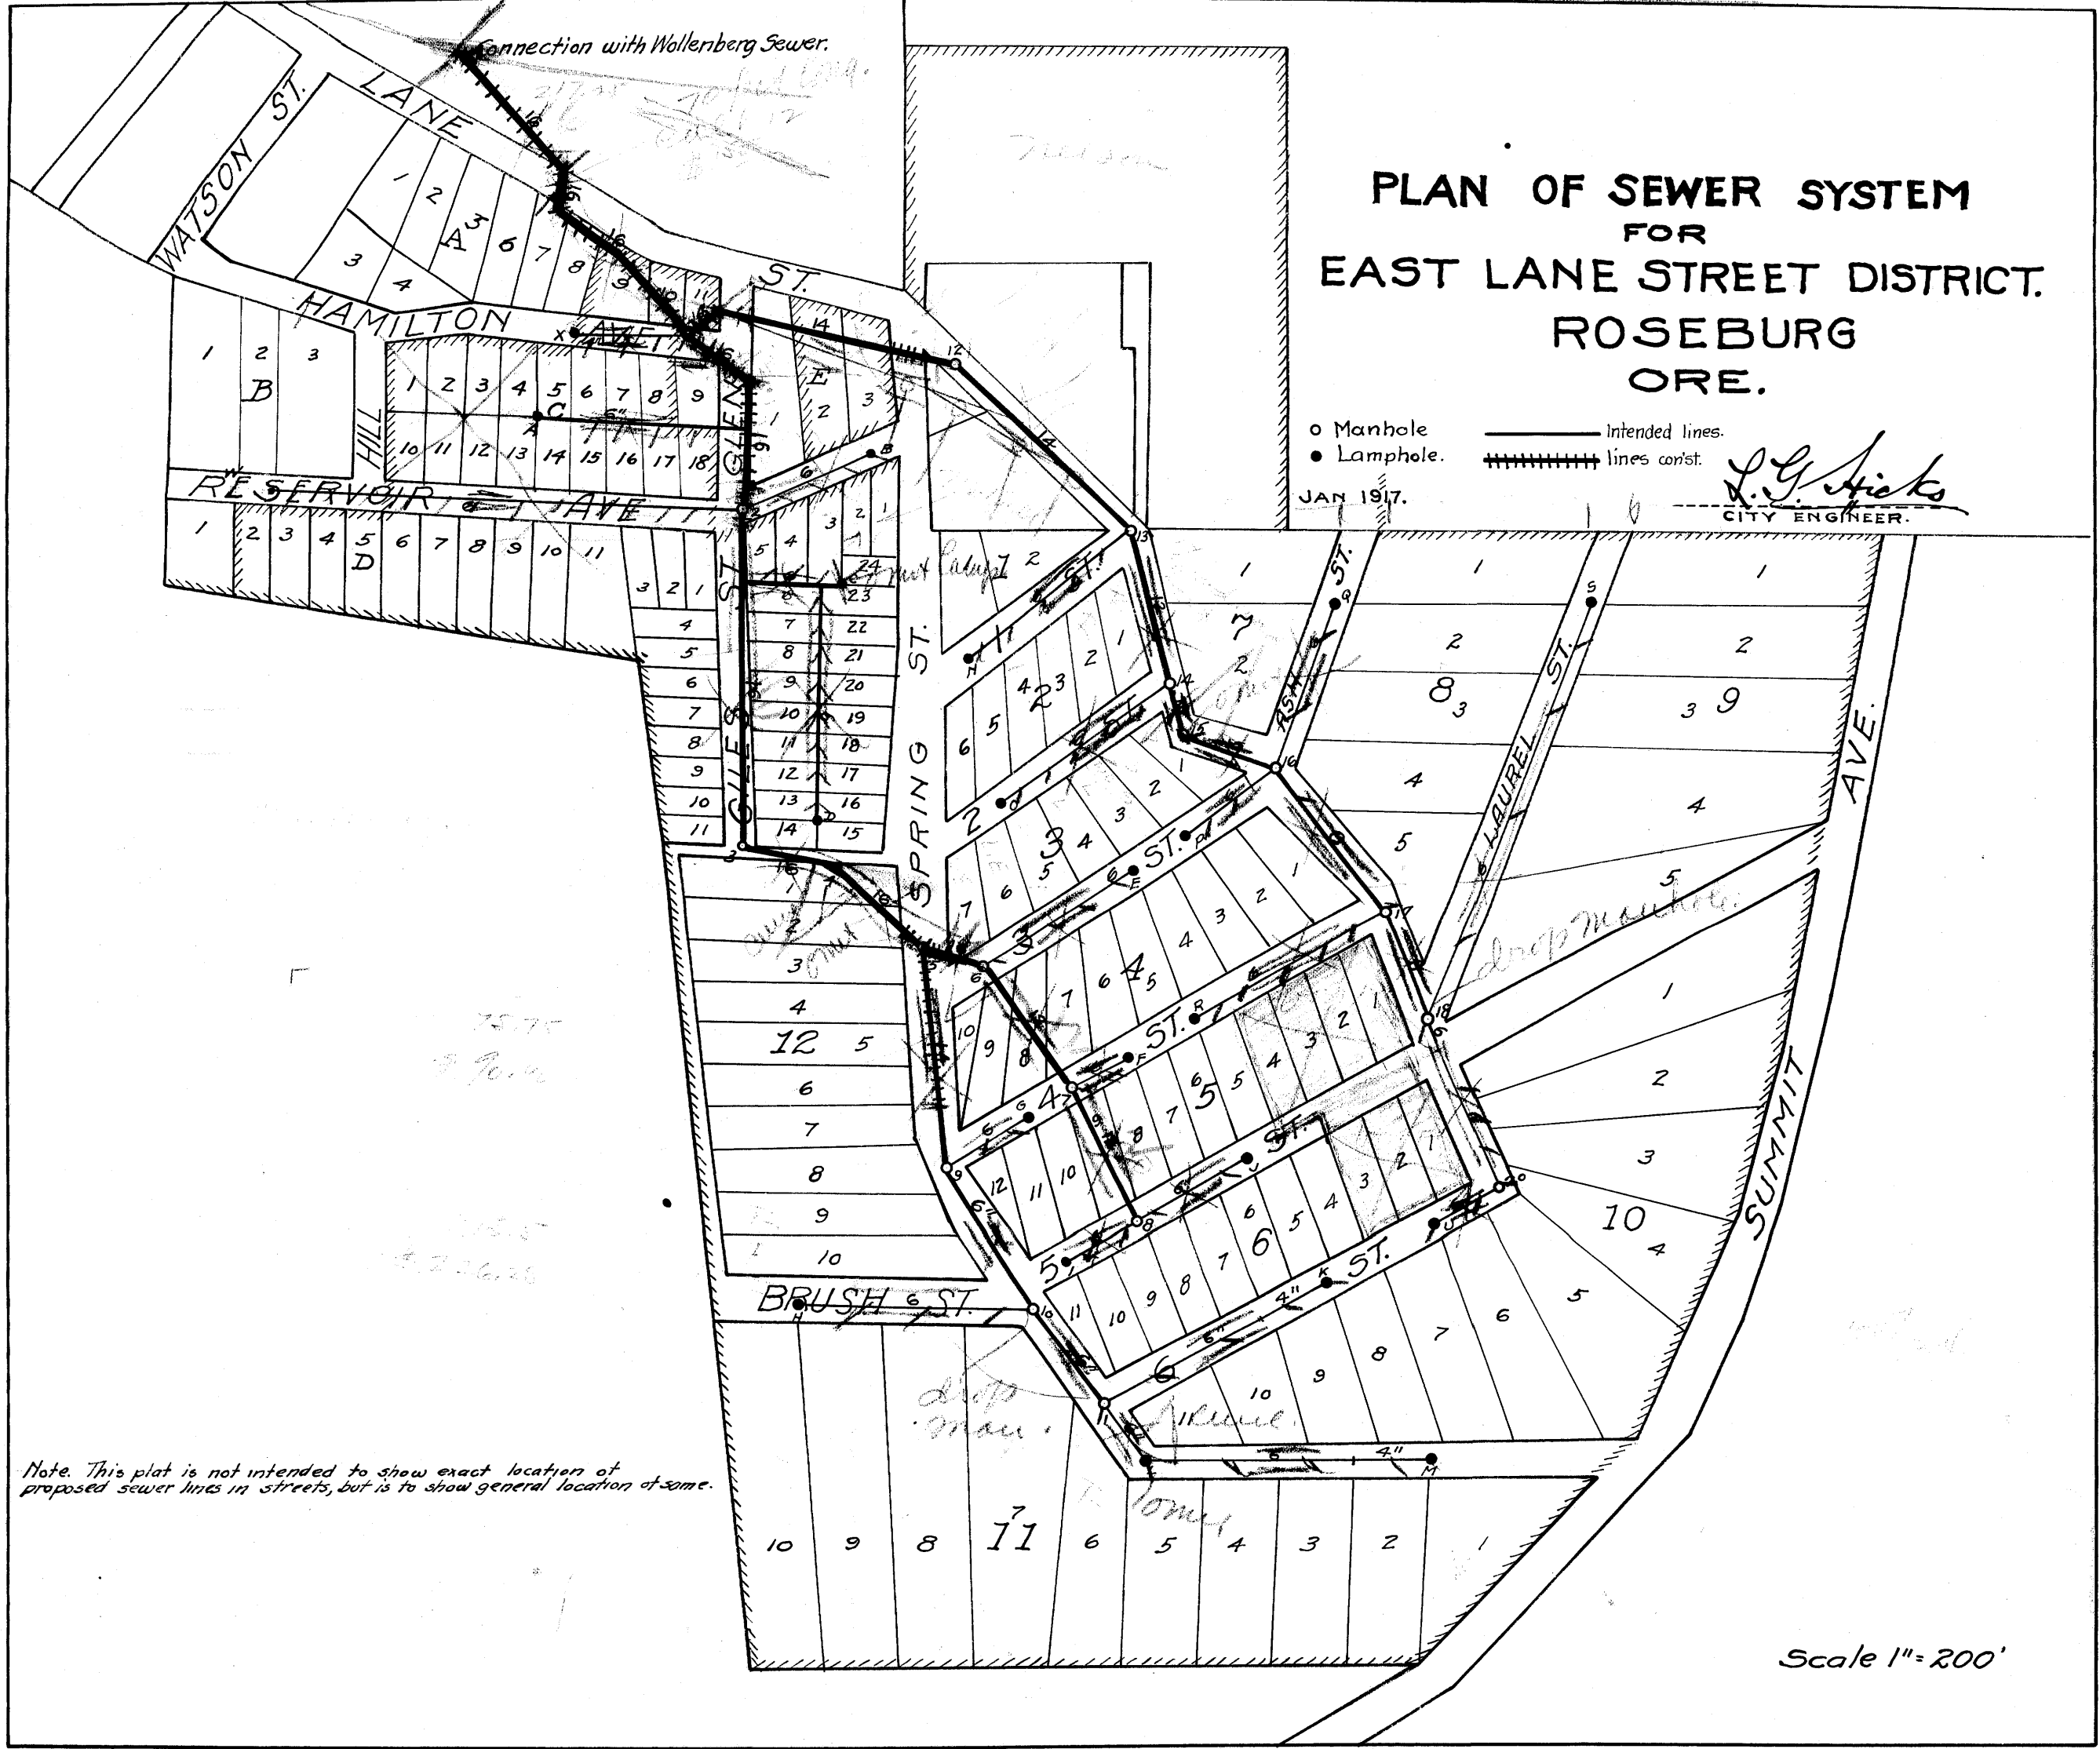

Note. This plat is not intended to show exact location of proposed sewer lines in streets, but is to show general location of same.

Scale 1" = 200'

CS FILE FOLDER

CONTAINS

MORE

INFORMATION