


460  
 5  
 3300  
 660  
 3960

30/28


# Austin (Merl)

May-13-1937  
 Boyer, W. Shaw

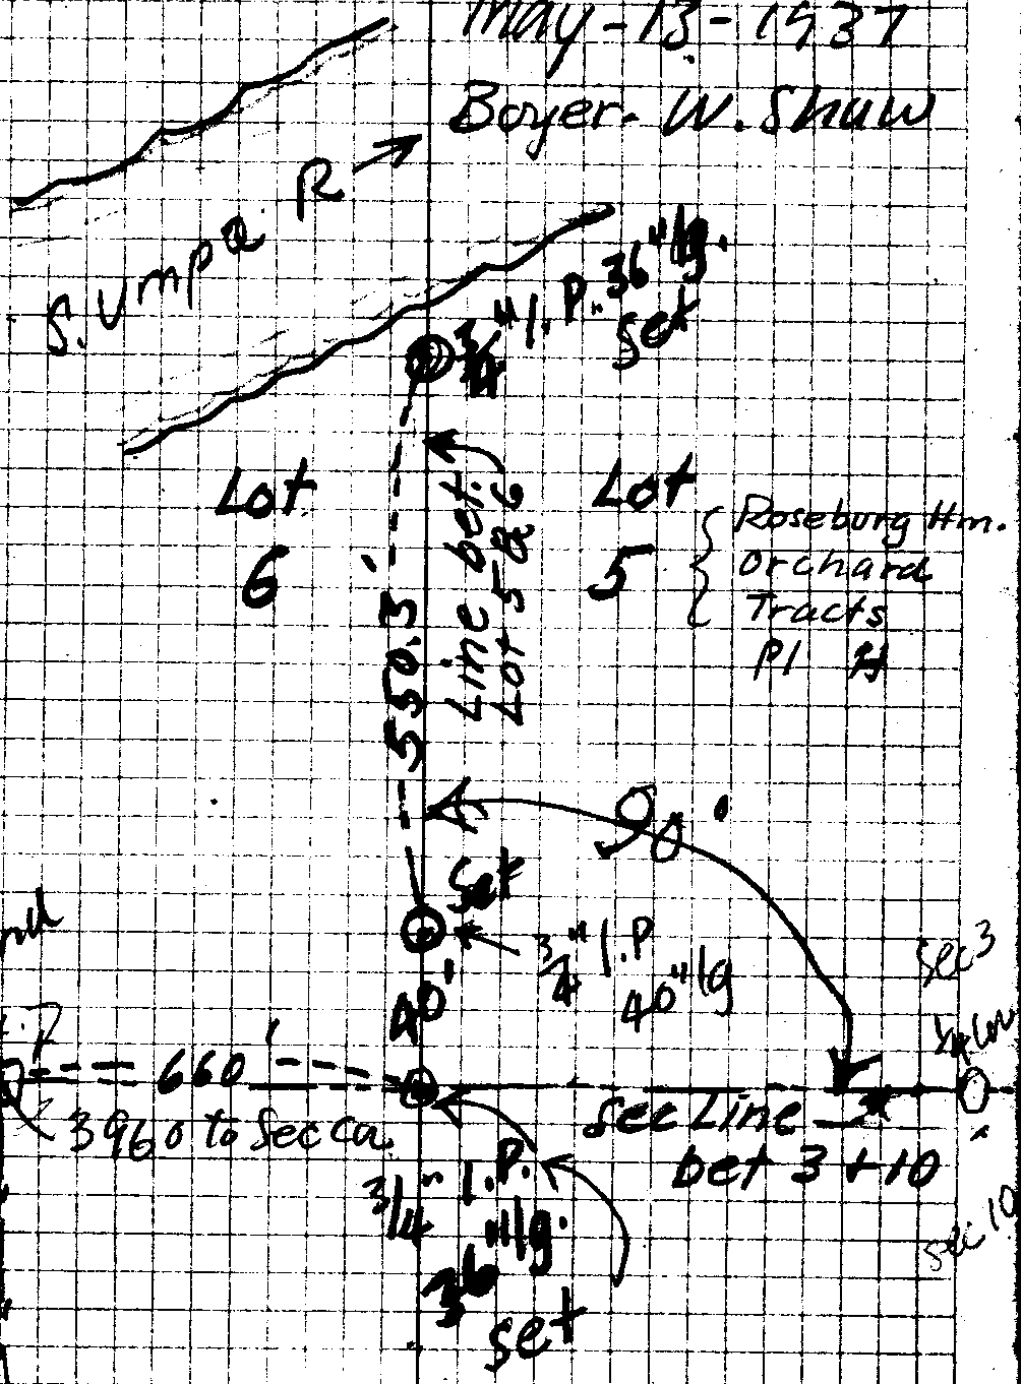

Sec 3 T28 S R 6 W  
 Line bet. Lots 5 & 6  
 Roseburg Hm. Orch Tracts.

V30 E28

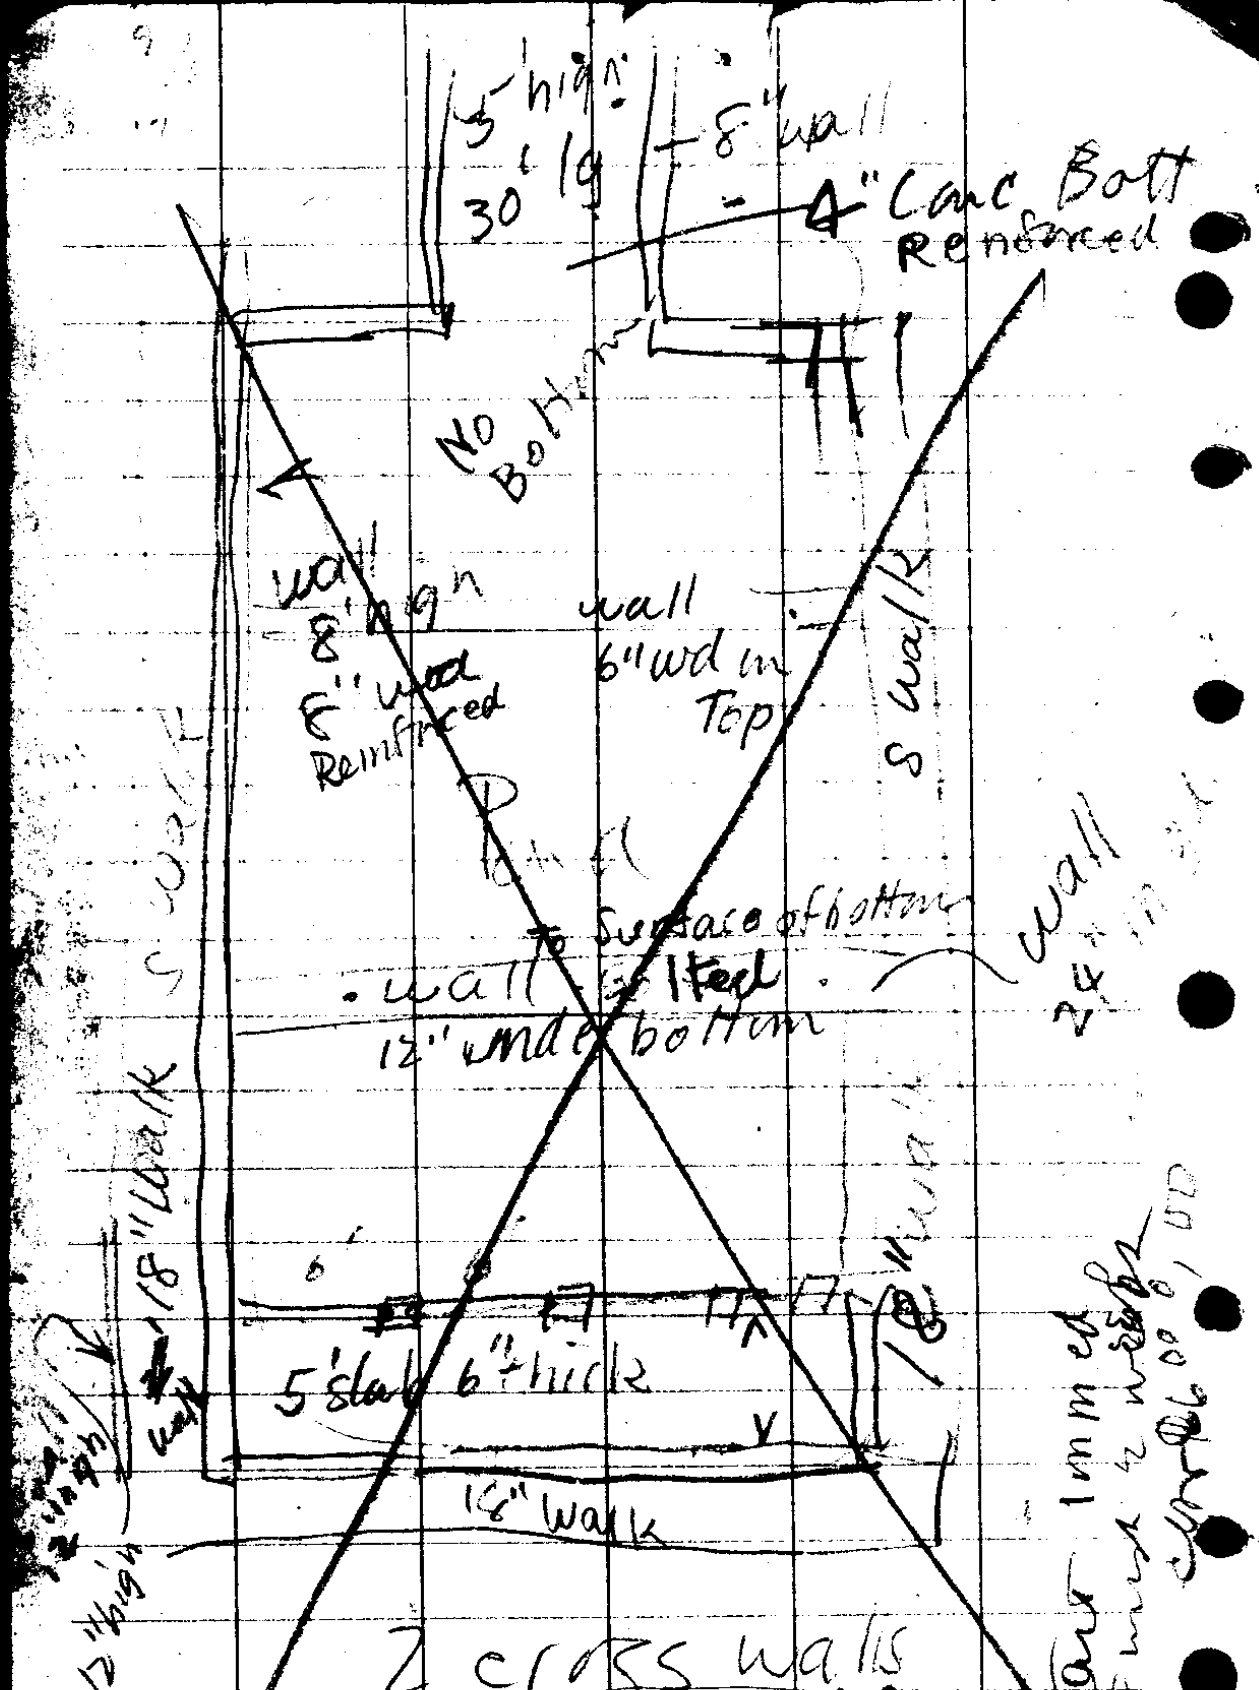

2 cross walls  
 50 HP - motor 15 Cent  
 440 volts  
 10" intake + Drench Low. 100  
 10" transite pipe  
 27' 1/2 ft Pipe Line level

3/10  
 1/2  
 1/2