


West Property Line

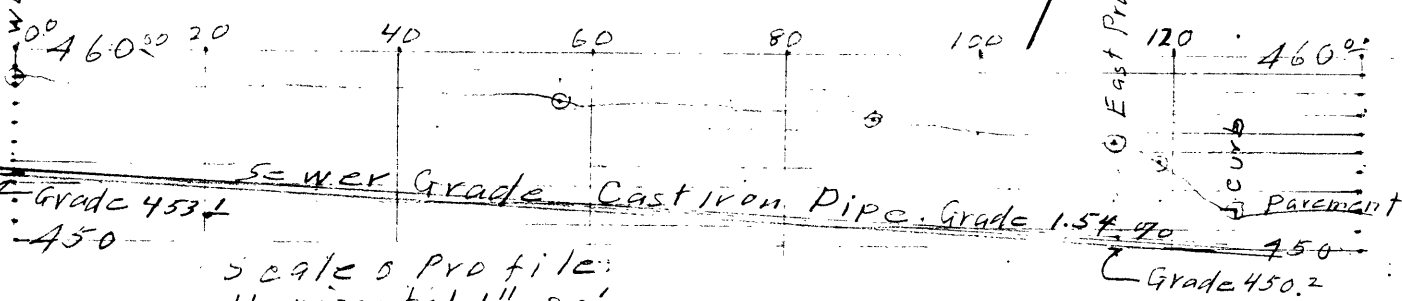


Scale of Profile:  
 Horizontal 1" = 20'  
 Vertical 1" = 10'

**LOT 2, BLOCK C, LAURELWOOD ADD  
 ROSEBURG, ORE.**  
**DATA FOR PRIVATE SEWER EASEMENT,  
 FROM ORE. WORLD WAR VETS. STATE AID COMSN.**  
 H. L. EPPSTEIN, CITY ENGR  
 JULY 1939  
 SCALE, 1" = 20 Ft.

NO. 11  
FOUN. 10

Jan-24-1928 } H. E. Eppstein  
A. Boyer  
B. A. Lane chain

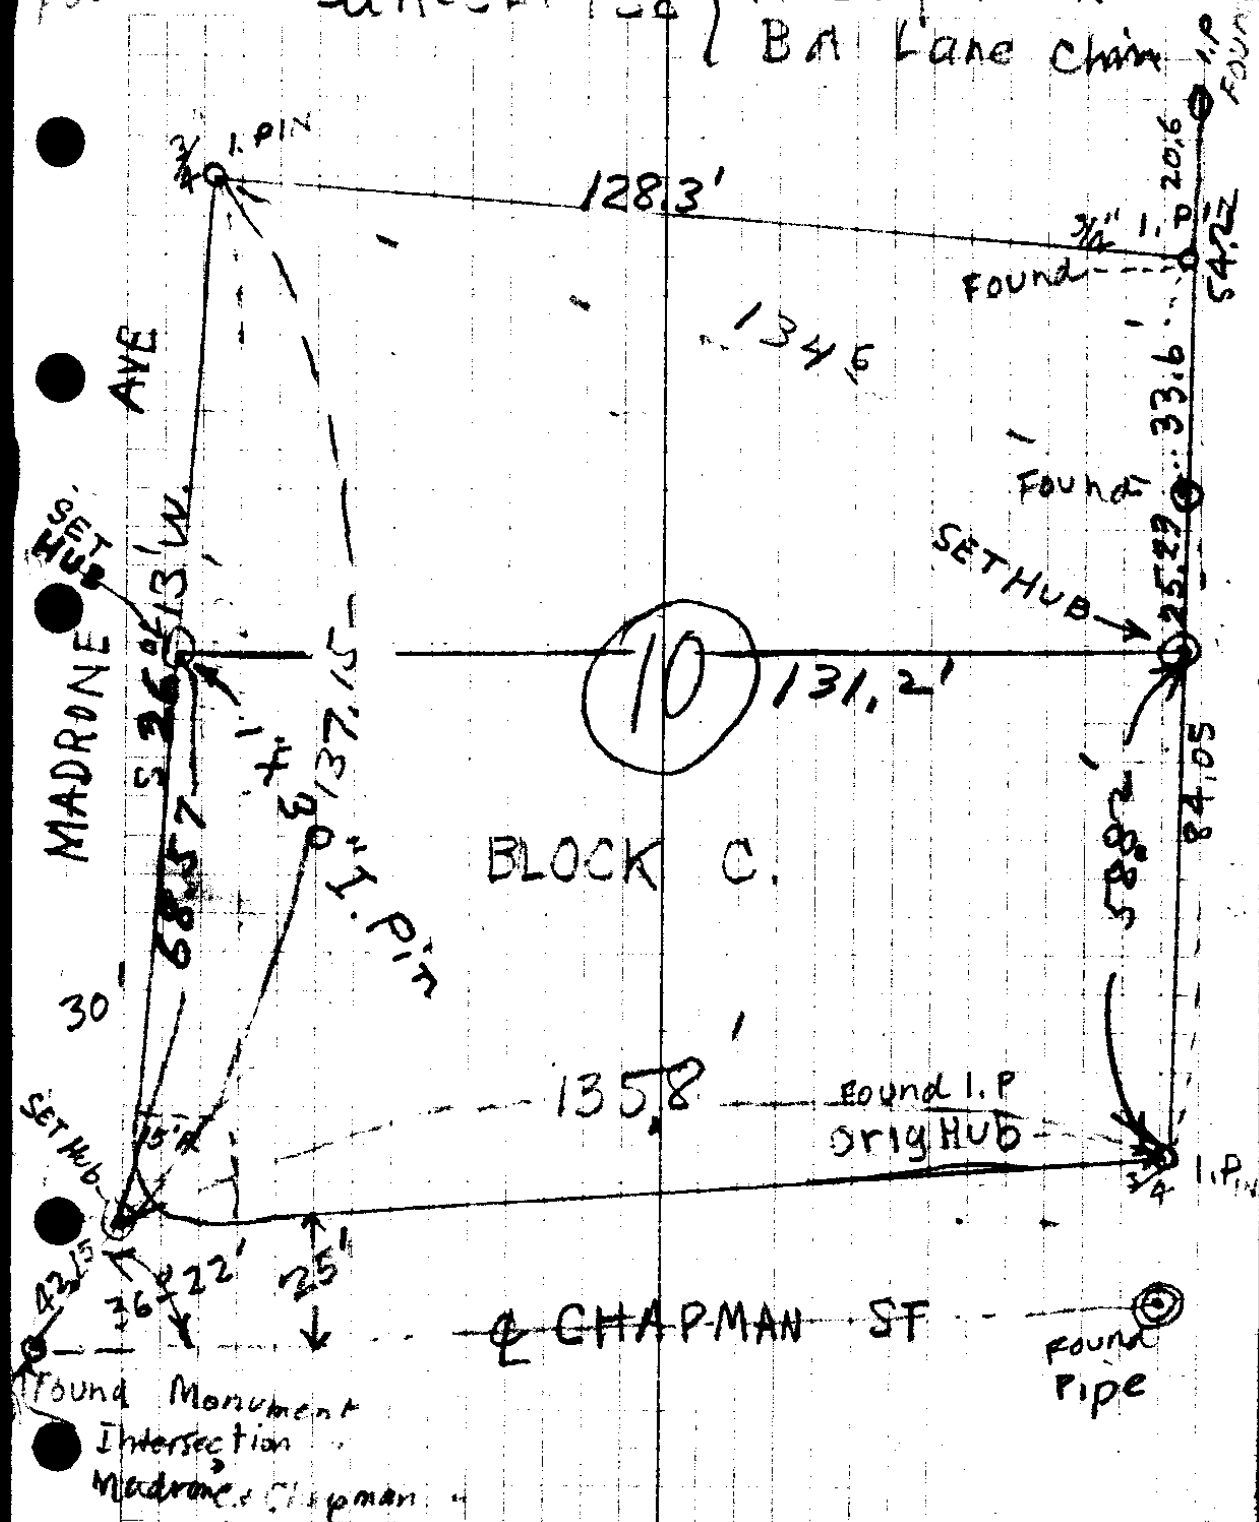


SURVEY FOR STEVE COOPER  
 S 1/2 LOT 10 BLOCK C, AMENDED  
 PLAT LAURELWOOD ADD. ROSEBURG

E 30-46

N.E. Richardson

B.A. Lane

Apr. 21 - 1939

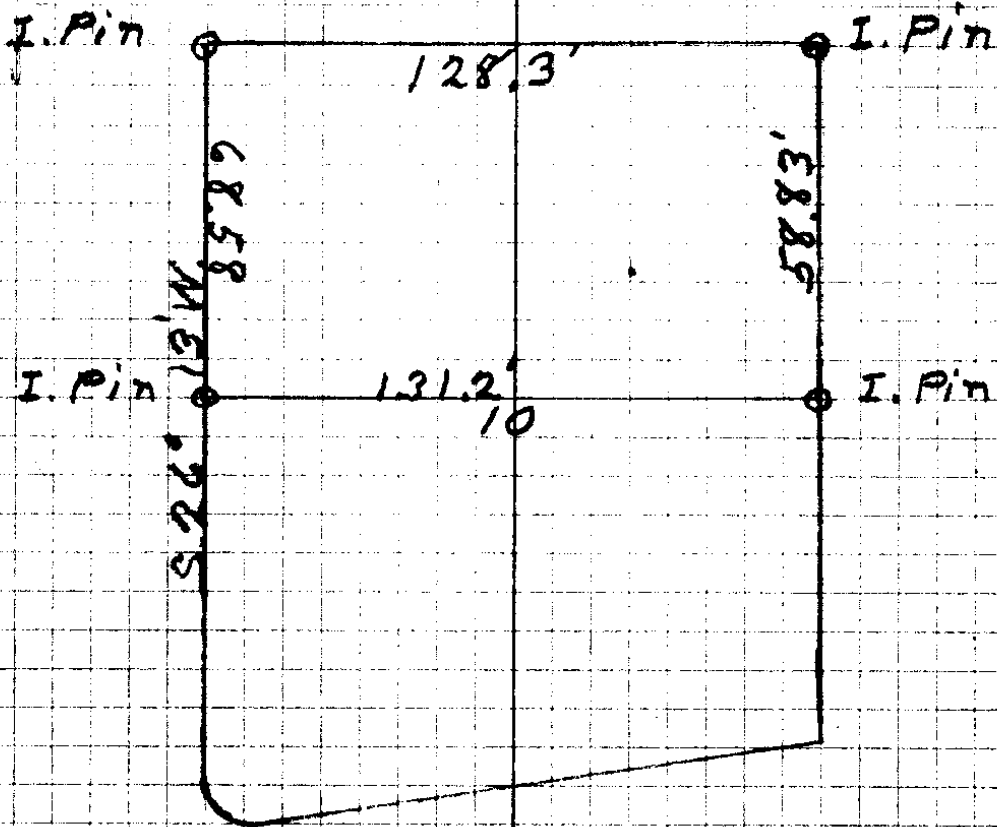

N $\frac{1}{2}$  Lot 10 Block C  
Laurwood

CS FILE FOLDER

CONTAINS

MORE

INFORMATION