


T. 32 S., R. 5 W.

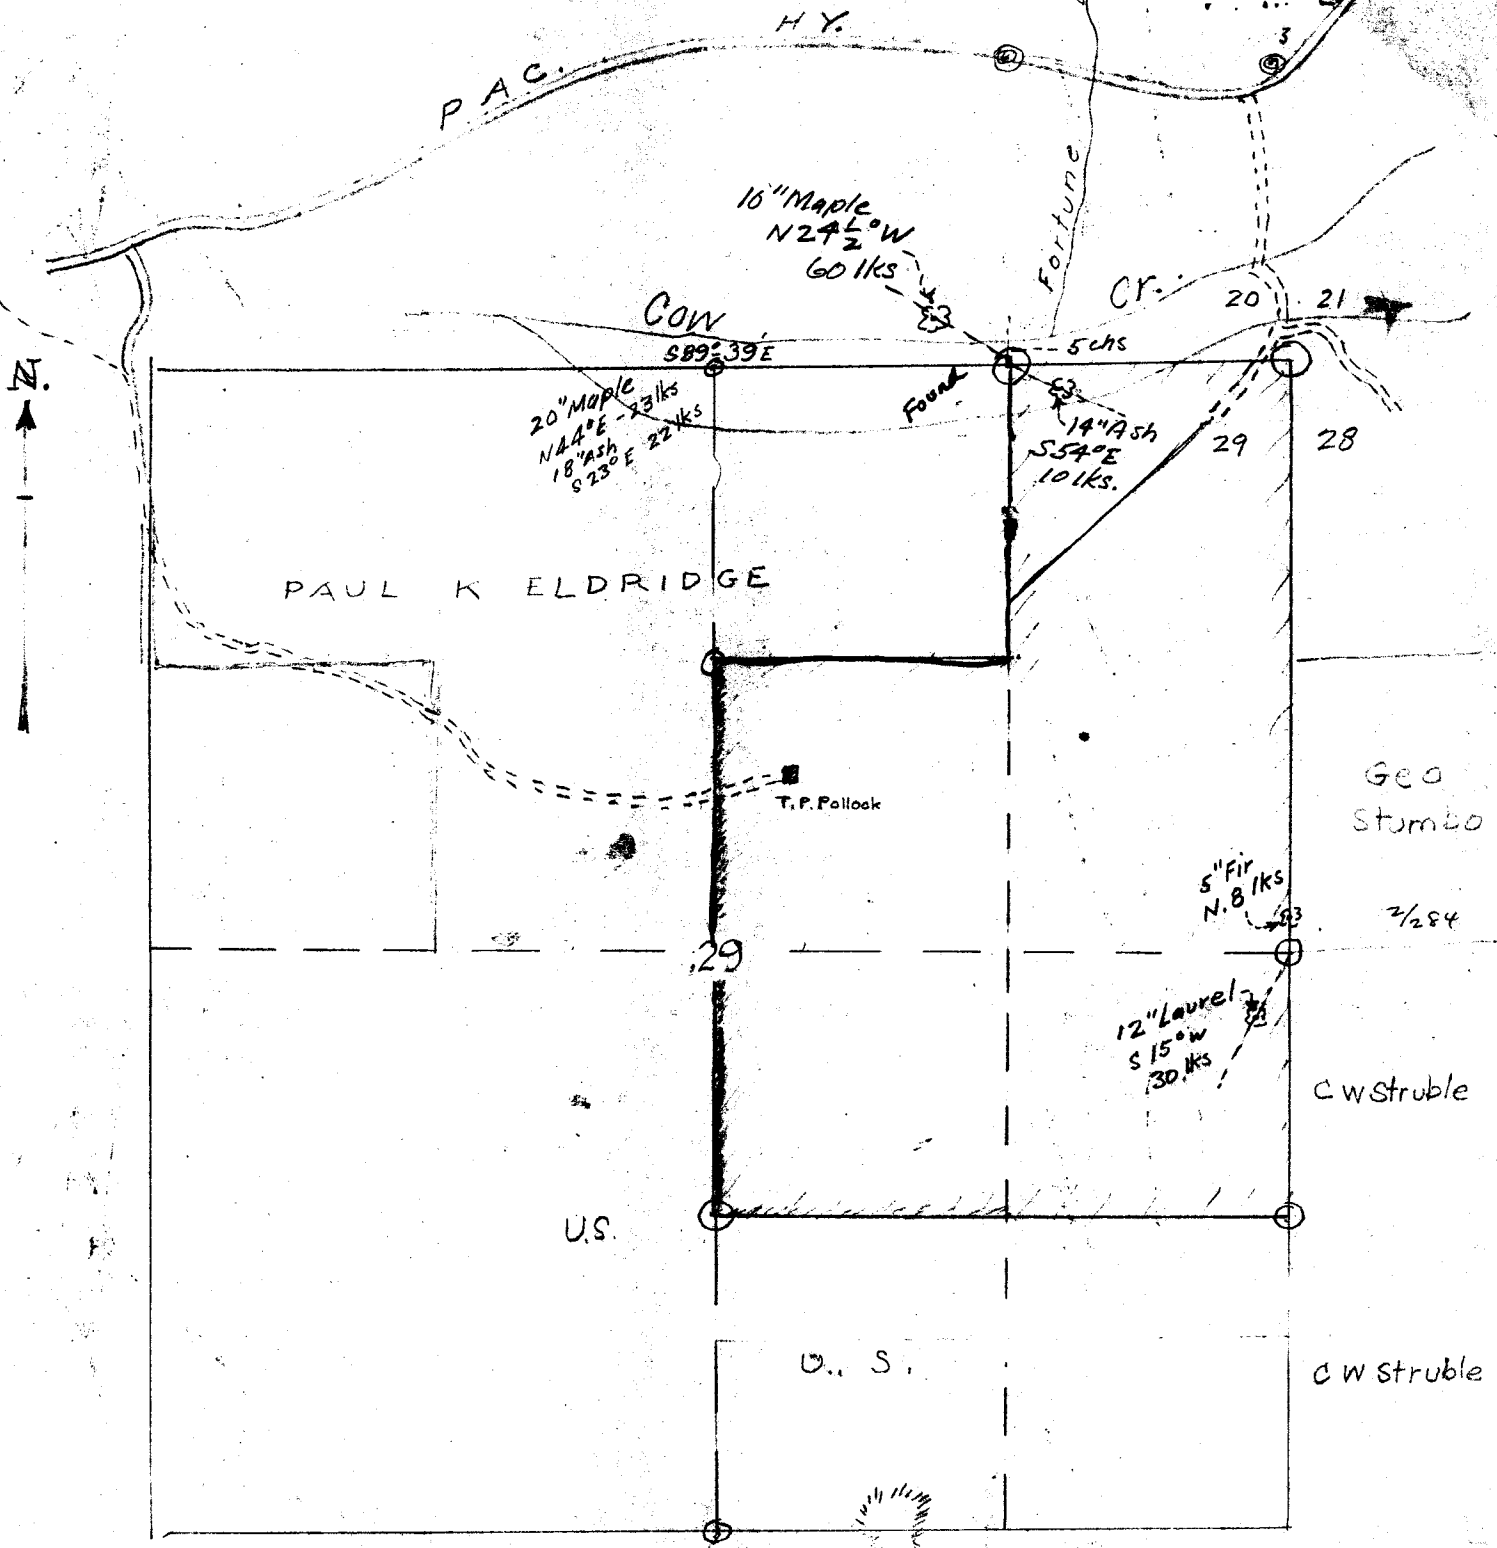

$$\begin{array}{r} 66 \quad 66 \\ 10 \quad 60 \\ \hline 660 \quad 3960 \end{array}$$

5" Laurel
 S 20° W
 20 lks.
 2-262