

The image shows a page of graph paper with a grid of small squares. A vertical line runs down the center of the page, and a horizontal line runs across the top. The grid is mostly empty, with some faint markings and a few small dark spots. There are four hole punches along the left edge of the page.

STATE Game Commission

Levels to determine difference in Elev. between Culvert under Road at New Pond by Elev. on Floor of Flume at

Upper dam in Rock Ck  
 STA +S. H.I. -S. Elev. Bottom of Culvert (Flow Line)  
 3.31 103.31 100.00

7.71 95.60

11.28 106.88

B.M. on Top Wood Stave Pipe Flume

8.20 98.68

4.69 102.19

⊙

10.85 113.04

1.19 111.85

⊙

7.89 119.74

1.60 118.14

⊙

2.76 120.90

9.03 111.87

⊙

1.81 113.68

11.64 102.04

⊙

1.20 103.24

Bottom of Flume, below upr. dam

4.67 98.57

Check Back

4.26 102.83

98.57

⊙


0.78 102.05

12.02 114.07

June 24, 1938

Sheet 1 of 2

A Boyer  $\pi$   
Workman on Construction Rod.

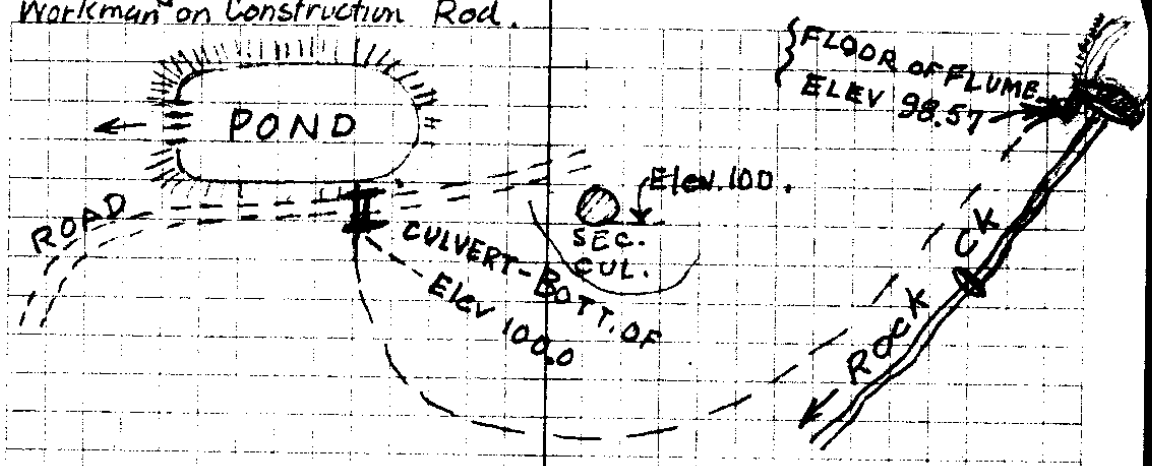

Sheet 2 of 2

Sta

+S

H1

-S

Elev.

114.07

⊙

2.19 111.88

9.89 121.77

⊙

3.62 118.15

1.94 120.09

⊙

8.23 111.86

2.25 114.11

⊙

11.90 102.21

5.09 107.30

⊙

11.68 95.62


8.05 103.67

Check  
Back.

3.65 100.02

Bottom of  
Culvert  
(Flow Line)



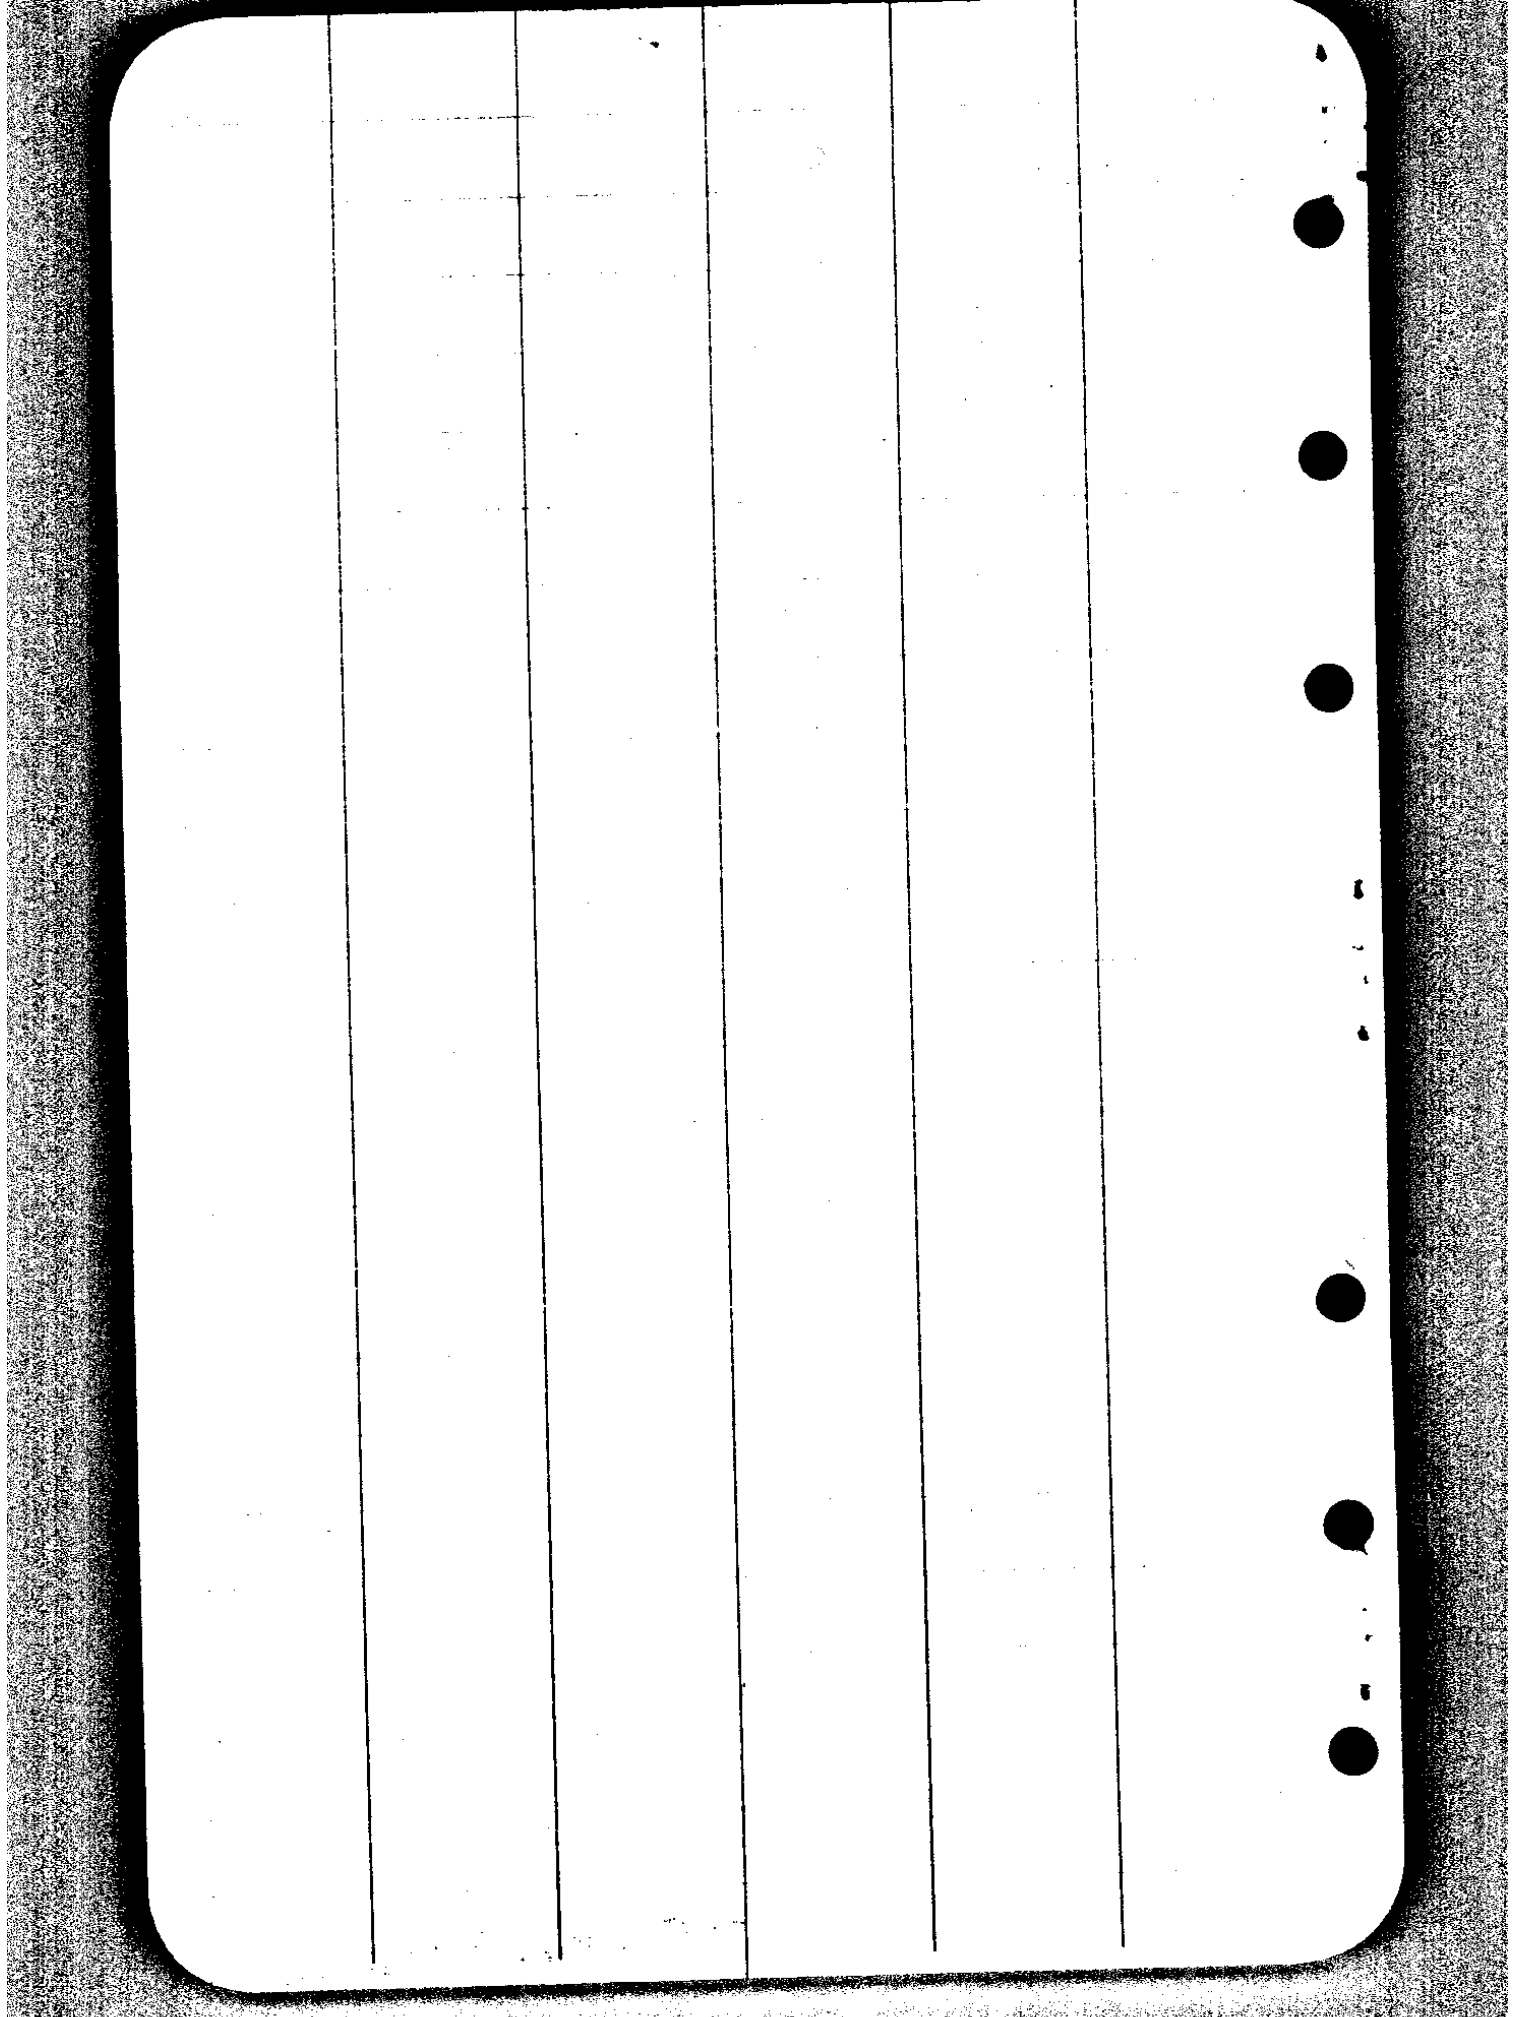

50-62

A large grid of graph paper with a vertical line down the center. The grid is mostly empty, with a few small marks and a handwritten '1' in the upper right quadrant.

S. P. R. R.

30/64

STATE GAME COMSN

Sta	+S	H I	-S	Elev
	3.31	103.31		100.
⊙			7.71	95.60
	11.28	106.88		
BM. Top Pipe on wire			8.20	98.68
⊙			4.69	102.19
	10.85	113.04		
⊙			1.19	111.85
	7.89	119.74		
⊙			1.60	118.14
	2.76	120.90		
⊙			9.03	111.87
	1.81	113.68		
⊙			11.64	102.04
	1.20	103.24		
Shot in Flume bottom			4.67	98.57
	39.10		40.53	
Check Back				98.57
	4.26	102.83		100
⊙	12.02	114.07	0.78	102.05
	<del>11.52</del>	<del>113.57</del>		12.0
⊙			2.19	111.88
	9.89	121.77		<del>111.38</del>
⊙			3.62	118.15
	1.94	120.09		1.54

Below upper  
dam.



Friday June 24 / 38

30-64

~~sq 100~~ ~~Ⓢ~~ Culvert

~~These notes  
copied NB.~~

~~100 210  
9857  
1.43~~

~~9857  
426  
10283  
78  
10205~~

C. S. File No. 30/64

Sta TS HI -S Elev

120.09

8.23 111.86

2.25 114.11

0

11.90 102.21

5.09 107.30

11.68 95.62

8.05 103.67

3.65 100.02

check  
Back