

N bet 27 + 28 - 73, 25 = 96
Cor 21-22-27-28

Basalt train

- 5" Hem - N12¹/₂ E 31
- 6" Arbitus S 80° E 14
- 8" Ching S 42 W 14
- 20" F N 75 W 51 L

N 0° 3' W bet 28-29

77-foot with

800 Basalt stone face 20-21-28-29

10" F. N 35 E 56

11" Cd S 45 E 16

48" R S 13 W 25

14" F N 57 W 71 Z

1900

3/18

12 100.0 -46° 179.0

11 27.3 -40° 30' 11.5

10 27.1 -35¹⁰ 30.2

9 46.3 42.4

8 = 104.2%

7 103.7 F 103.7

6 End Tues. AUG 17

5 92.9 +18¹⁰ 87.4

4 148.2 +19¹/₂ 131.5

3 60. Flat +12° 97.8

2 300 +7¹/₂° 271.5

1 63.1 +12¹/₂° 97.6 61.5

North 145° +10° 98.5 143.5

Car 14

7/4/21

31/18

372

57.7 F

118839

F

1833.9

N

1769.7

N

105.6

-272

909

379

N

80.9

-213

52

1600.4

N

113.0

-19845

1523

1494.6

125.1

F

N

65.0

-22845

599

14

28.3

F

3

207.5

502

119 28.59

1.5616

4066.0353 (68.3)

2
07

1066

123

1024

11.13

1039

177

1056

867

7342

7489

444

1536

1887.7

5172


1841.1

1324

61

1385

31/18

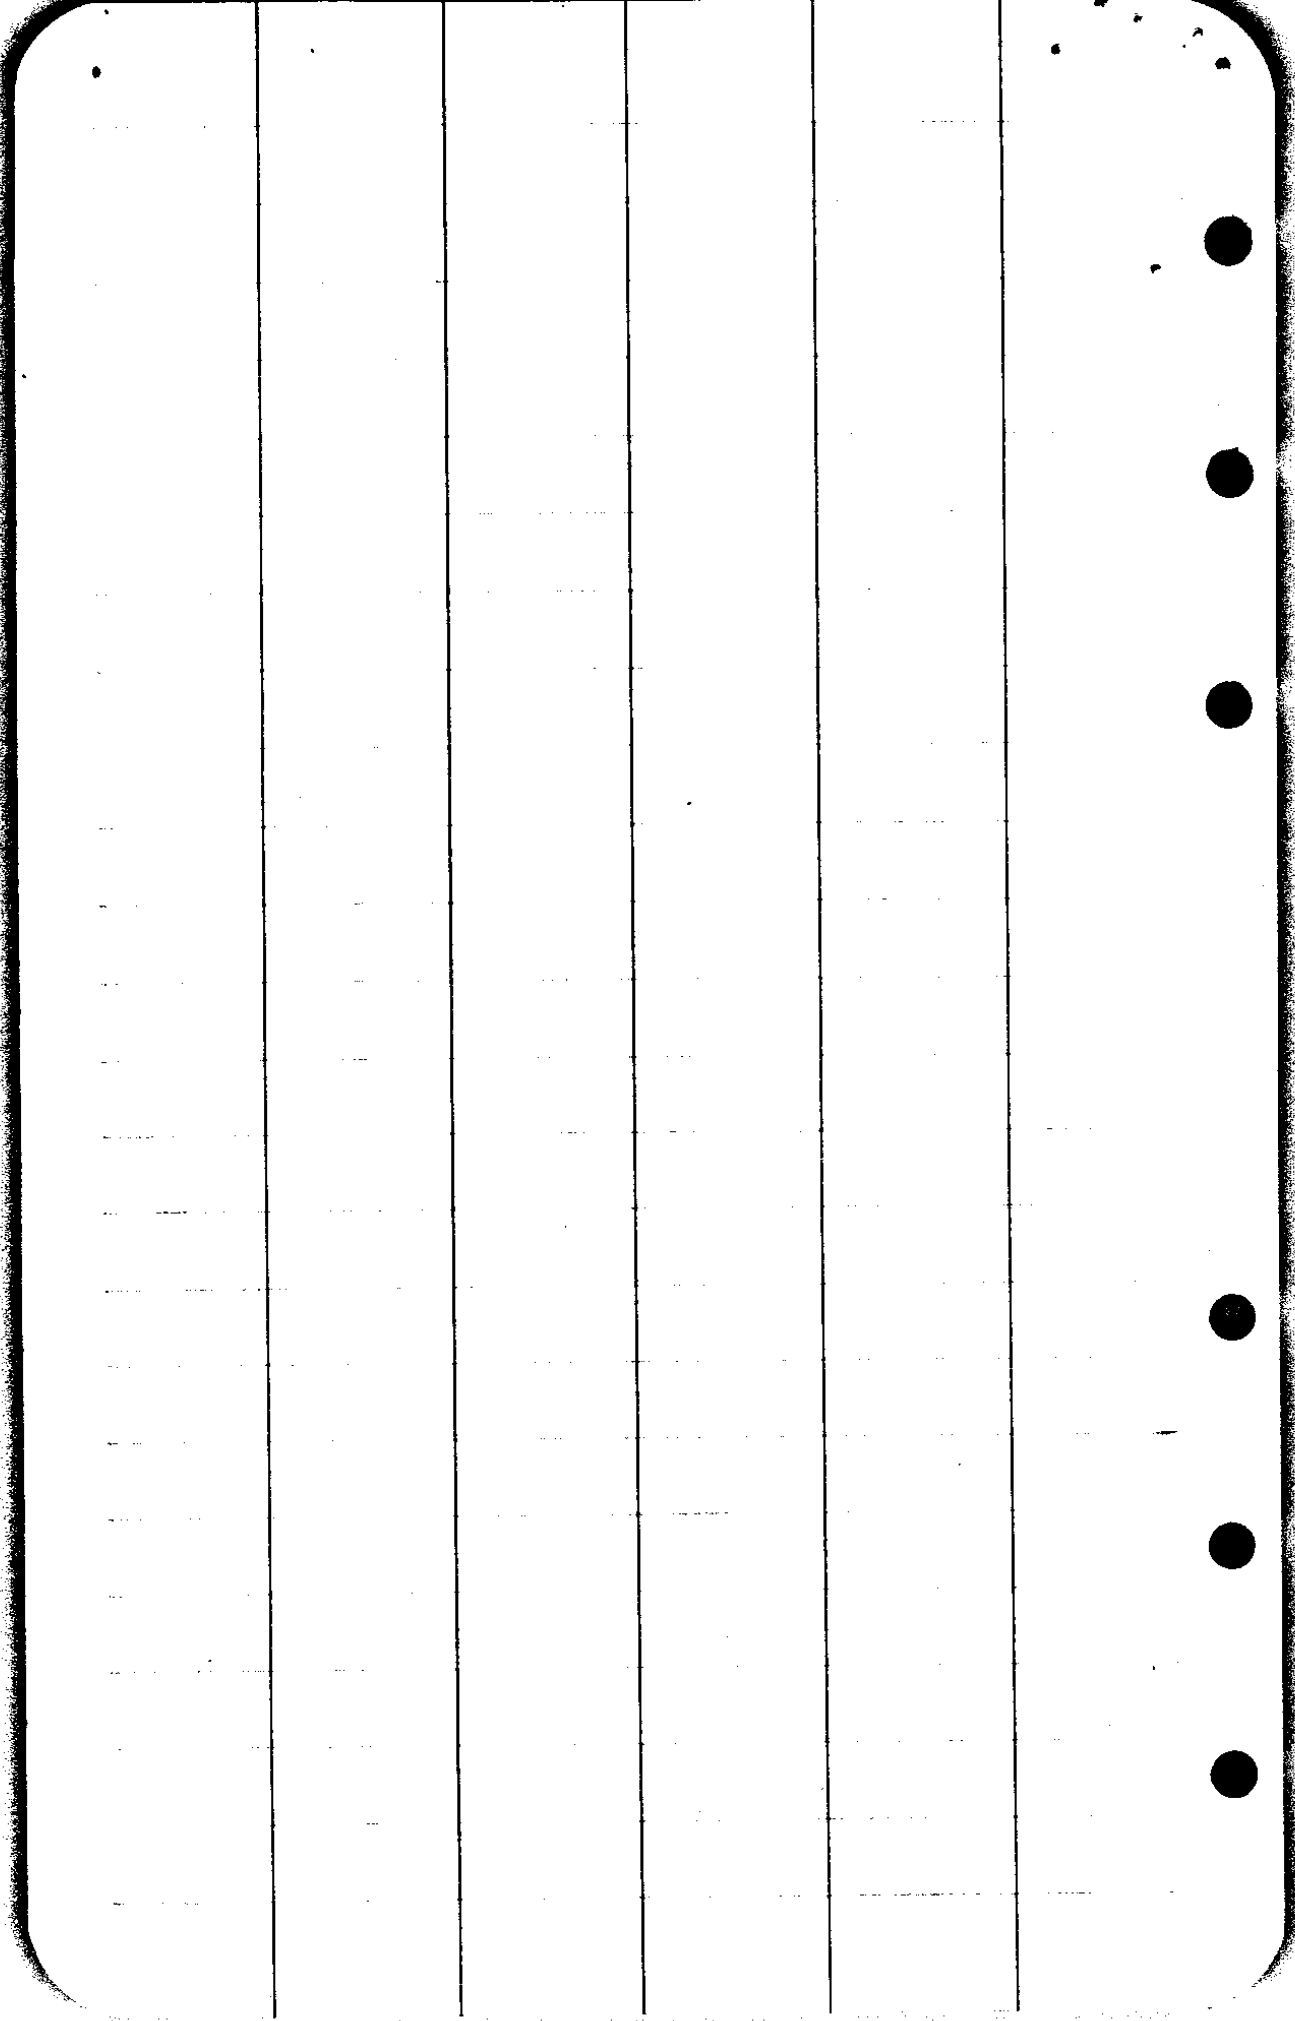

981	974	7
<u>136</u>	<u>117</u>	
2993	6818	
	177	
	104.2	6

— x — x — x —

460
 54
 13.1
 12" W.O.

⊙ 13

31/18

Hallmark & Comfort

Aug-17-19 W 118.2 m -20° 45'

11 W 89.4 F

W 73.4 F

10 = 1109.0

W 128.6 $-9\frac{1}{2}^{\circ}$ = 126.8
 .986

9 = 928.2

W 76.0 $-11\frac{1}{2}^{\circ}$ = 74.5
 .988

1/6 cal
 6.14
 x 1000

8 = 853.7

1015

7 = 752.2

F 170.6

6 = 581.6

W 238.0 $-18\frac{1}{2}^{\circ}$ 226.1
 .950

5 = 355.5

W 140.9 $17\frac{1}{2}^{\circ}$ = 134.4
 .988

4

W 19.1

3 END Tues Aug 17

W 50.4 -29° 44.1
 .875

2

W 49.2 -13° 47.9
 .974

1

W-110.0 F

546W
 46W
 - 300

1245
 75
 1286
986
 7716
 10288
11574
 126.7996

238
226
 12
 1320
1128
 192
 89
1109.0
 1026
 9822
 1268
73.4
 1128.4


1 24.45
 1 868) 2500 (182
868

750.0
40
 740

1580
868
 7120
444
 1760
1734
 24

1320
963
 2283
 2283
854
 1429
 2644
2283 = 2010
 357
 shut
 178.5

90
64
 36

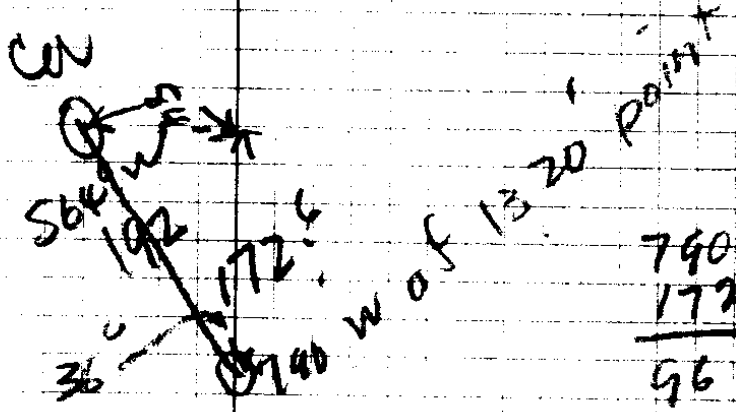

790
172.6
 962.6

Or 438
 Sw 846
 1320
1170
 1170


899
142
 798
 8091
599
 1197.608

1923
438
 1536
 576
768
 84096

1320
963
 357
 1320
963

31/18

212283.
1141.

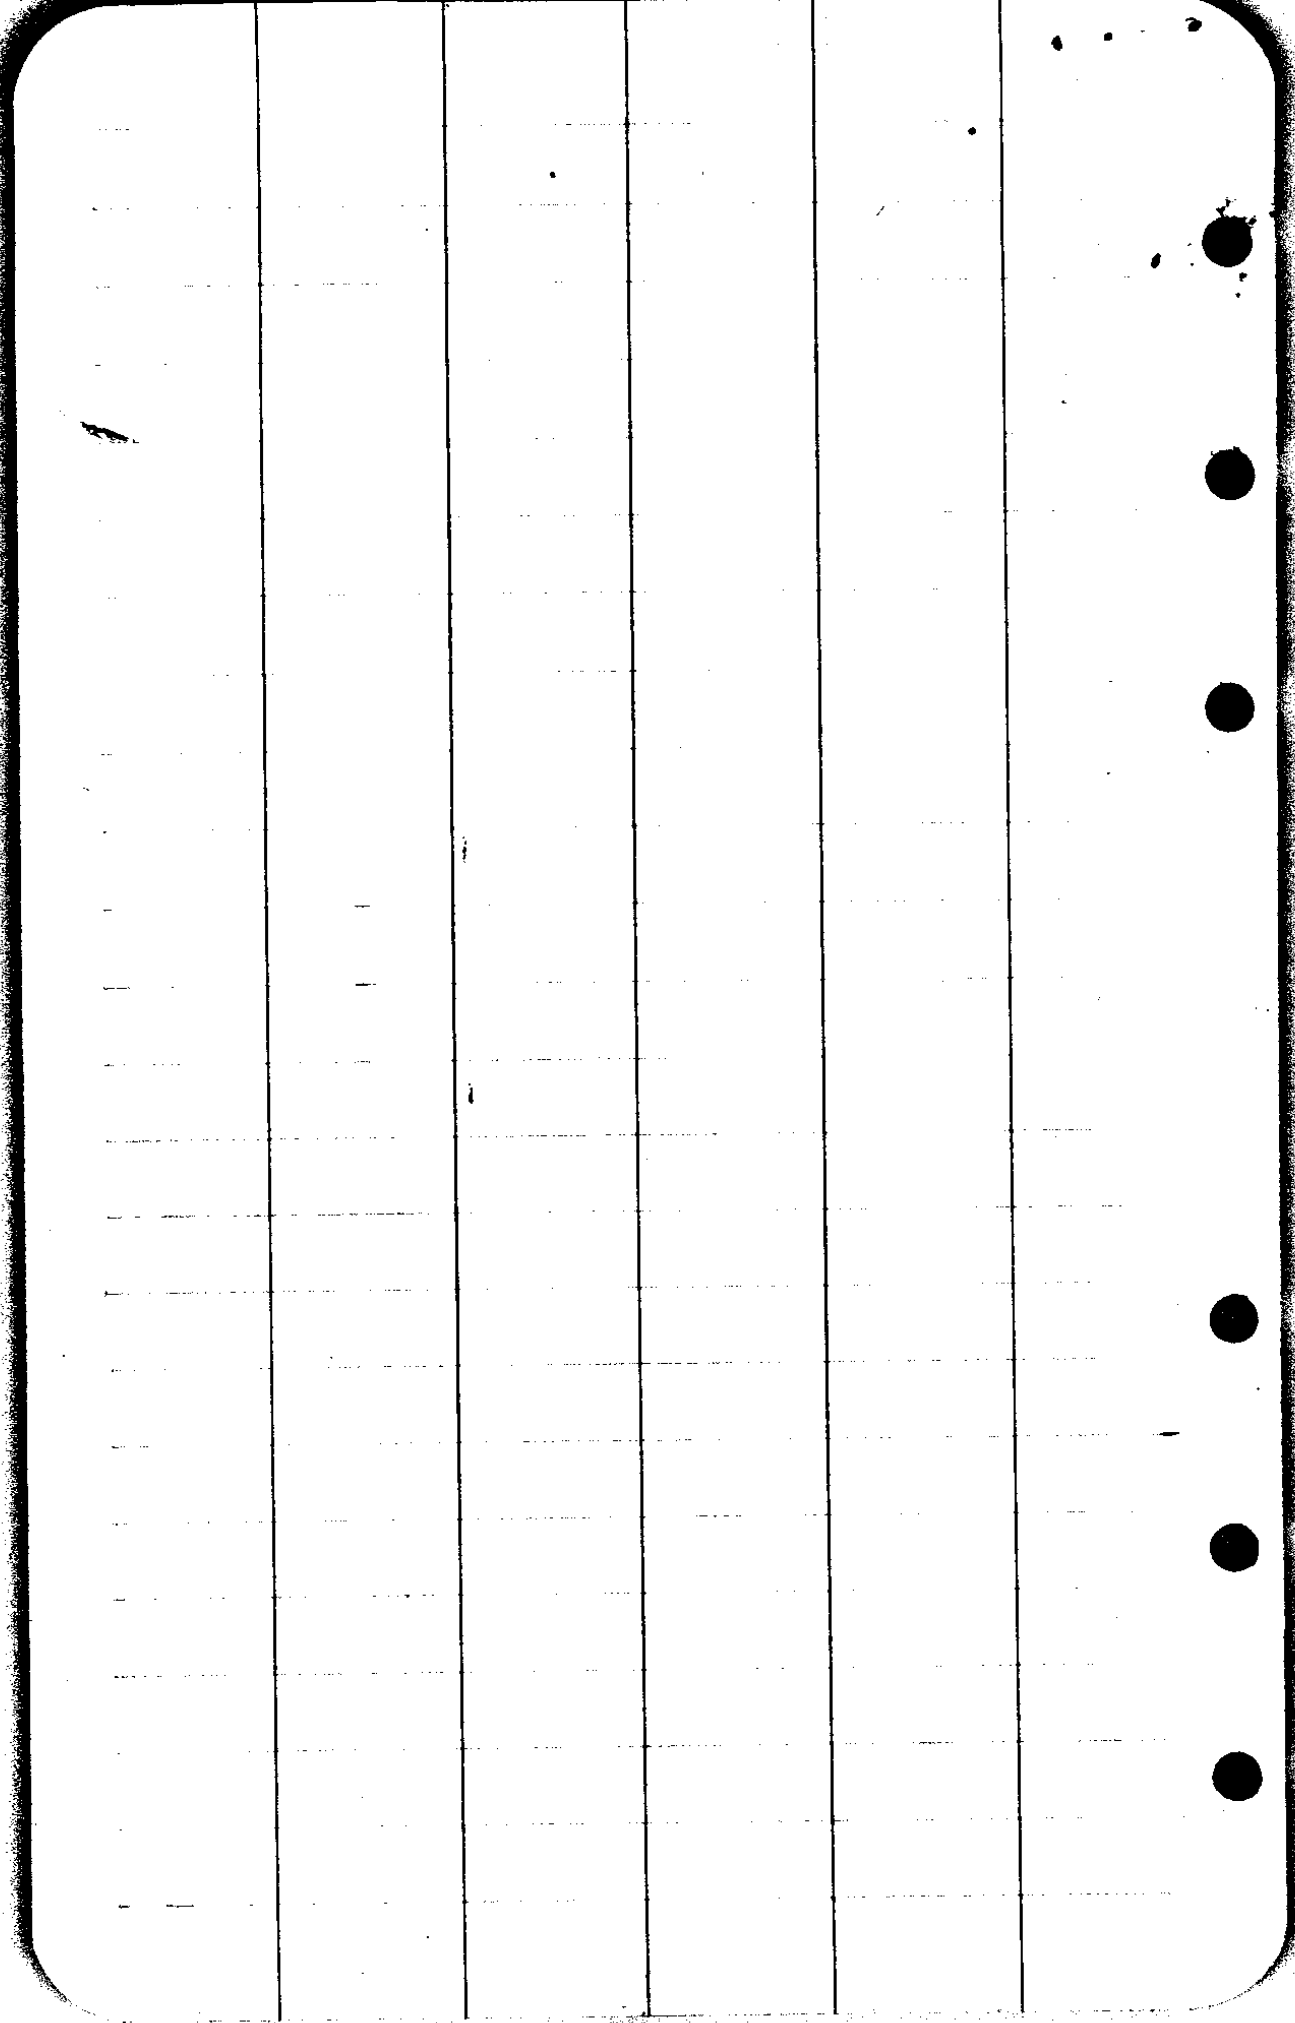

n bet 21 + 22

10.0 = Spruce

15.5 Rainie

20. Spruce

25.25 Spring Branch

27 = Spruce

30.5 = Rainie

40 = Top Spruce = Co

48" Ced S 80 W 15.7 Z

54" Pine S 56 E 21.7

66.5 Muller L

71 = Beat

80 = Co 15-16-21-22

Basalt Rock

7" Hem N 52 E 38 Z = 25.1

12" " S 45 E 20 = 17.1

13" " S 78 E W 36

14" Map. N 68 W 28 = 18.2 (940)

38	66
66	78
228	528
25.8	18.48
	26
	66
	156
	17.16

July 9

n bet 28-29

77 = Creek

80 = Co 20-21-28-29

Basalt Stone

10" F N 35 E 56

11" Ced S 45 E 10

48" F S 13 W 25

14" F N 57 W 71

Sedro Wooley, Wn-
June 7, 1944.

Mr. Arthur Boyer
Roseburg, Ore.

Dear Mr. Boyer:

Have just caught up to my mail after a month of cruising on the Suiattle River, White River and on the Skykomish River near Index. This is a rugged country.

Your letter of May 27th is at hand and I will answer it, tho I suppose the information you have asked for will be obsolete by this time.

On March 9-1944 I ran the east boundary of Sec 21 T 25 S Range 2 West. Starting at the corner of Secs 15/16/21 and 22 T 25 S Range 2 West I chained south on the sec line between Secs 21 & 22 in order to find the $\frac{1}{4}$ Cor Secs 21 & 22. The corner was approximately 2 chains south of the correct distance and did not fit the description of the topog to Millers Creek, but the corner was as described and I found a 48" (64" now) Incense Cedar 157 links South 80° W. with a witness blaze on it. I did not chop out the blaze to find the scribe as I fear the worms

2. have done their worst. The other witness tree described in the notes was a 54" Sugar Pine. I found the shell of a burned pine stump 21 links South 56° East which fitted the description of the witness. I did not look for the South East corner of the Section as it was late and I felt reasonably certain that the information I was in possession of would satisfy my purposes.

Tell my cousin Armour Murdock that I am surprised that a Murdock should leave a nice sitting down job and start jumping around among the hills like the rest of the goats. I'm beginning to think the Murdocks have a chronic affliction that way.

Hope the above information may be of some use to your office.

With best wishes

Glen E. Murdock

Box 186 - Sedro Woolley, Wn.
(for the present)