


27
4

Maur

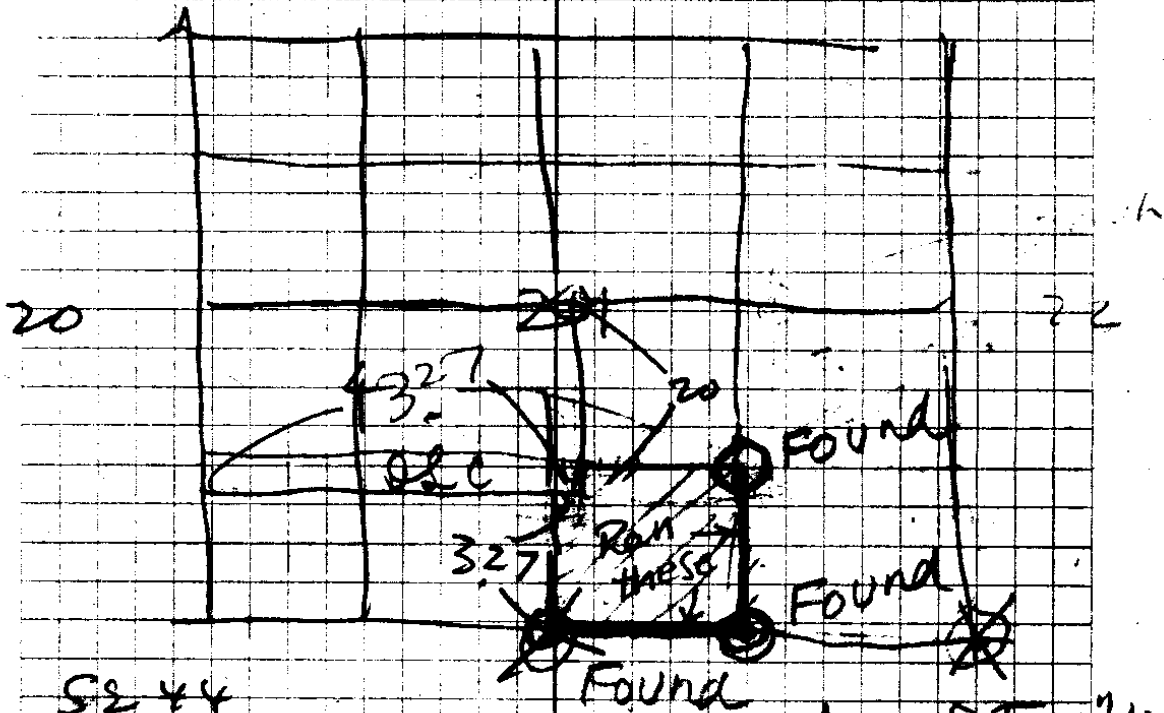

S 2 44

26" W.O S 30 E 9 2 7

New BT = 12" W.O
S 80° E 14.3

78

27

21-22-27-28 Stewart 1922
Grand

1/4 Cal bet
21/28

Ante
x
1927
OB

24" B.O	N 72 W	18.5'	OB T.
18" W.O	S 15 W	13.5'	6
18" B.O	N 89 E	16.9'	7
18" B.O	N 75 E	7.3'	

5 Pipe
12" W.O N 75 E 50
12" W.O N 27 E
34.3

1/4 Cal bet 21-22

79.38
3608
43 27

1/4

1/4

20" B.O N 55 W 21
73" W.O N 56 E 75

MANZ

6	→ 170.5	-33 ^{1/2} °	= 142.5
	39.0	.836	
5			
	222.5	+10°	= 219.1
4	= 773.2	.985	
	300.0	-13°	= 292.2'
	.974		
3	500	F	
	N 107.0	F	
2	N 88.0	F	
1	N 236.0	F	
1/16 Cor			

5 - 1261.8 = 13' s of cor
 and at corner
 300 = 15° = 289.8

4 = 972.0
 246.0 - 11° = 241.5
 .982
 300 - 13° = 292.2
 .974
 300 - 25° = 271.8
 .906

3 Δ 0-11' L

1/16 Cor
 1320 = 2 * 186.0 - 26^{1/2}° = 166.5
 201.1 * 183.F
 58.8 F
 } at 1290.9' W of.
 } SE Cor 21 Set. WLT
 } Tree 20" Fir Bark Stripped
 } N 78° E 20' 1/2" I. Rod

1 = 1078.3
 223.0 + 28° = 196.9
 .843
 300 + 17° = 286.8
 .956
 300 + 11° = 294.6
 .982
 300 Flat

SE Cor Sec 21