

~~30-60~~ 31-61

Glide School Data
for
Sewerage + Drainage

Sept-13-'38

A.B.
W.S.R.


~~30-69~~
31-62

The image shows a page of graph paper with a grid. A vertical line runs down the center of the page, and a horizontal line runs across the page near the top. The grid is mostly empty, with some faint, illegible markings scattered throughout.

31/62


Drain from Bldgs + Diamond

| Sta | +S | #1 | -S | Elev |
|---------------------------------|------------------------------|----------|-------|----------------------------|
| | | | | 694.0 |
| | 8.56 | 702.56 | | |
| 4+10 | FL. Tile 6" | | 11.42 | 697.14 70.64 |
| 3+84 | | | 9.1 | 93.46 |
| 3+16 | | | 7.4 | 95.16 |
| On steps (conc) Front School | | | 1.22 | 701.34 ✓ |
| | | | 0.47 | 702.09 ✓ |
| | 5.02 | 707.11 | | 702.61 |
| 2+63 | | | 4.5 | 702.61 |
| 2+00 | | | 4.5 | 702.61 |
| 1+60 | Δ | | 4.9 | 702.21 |
| 1+00 | | | 4.8 | 702.31 |
| 0+0 | | | 4.8 | 702.31 |
| | | | 4.64 | 702.47 ✓ |
| | Line to Sewer outlet 5.64 | 708.11 ✓ | | |
| 5+50 | END | | 8.8 | 99.31 |
| 5+44 | | | 8.8 | 99.31 |
| 5+39 | | | 7.7 | 700.41 |
| 5 | | | 6.4 | 01.71 |
| 4+70 | | | 5.3 | 02.81 |
| 4 | | | 4.7 | 03.41 |
| 3 | | | 4.9 | 03.21 |

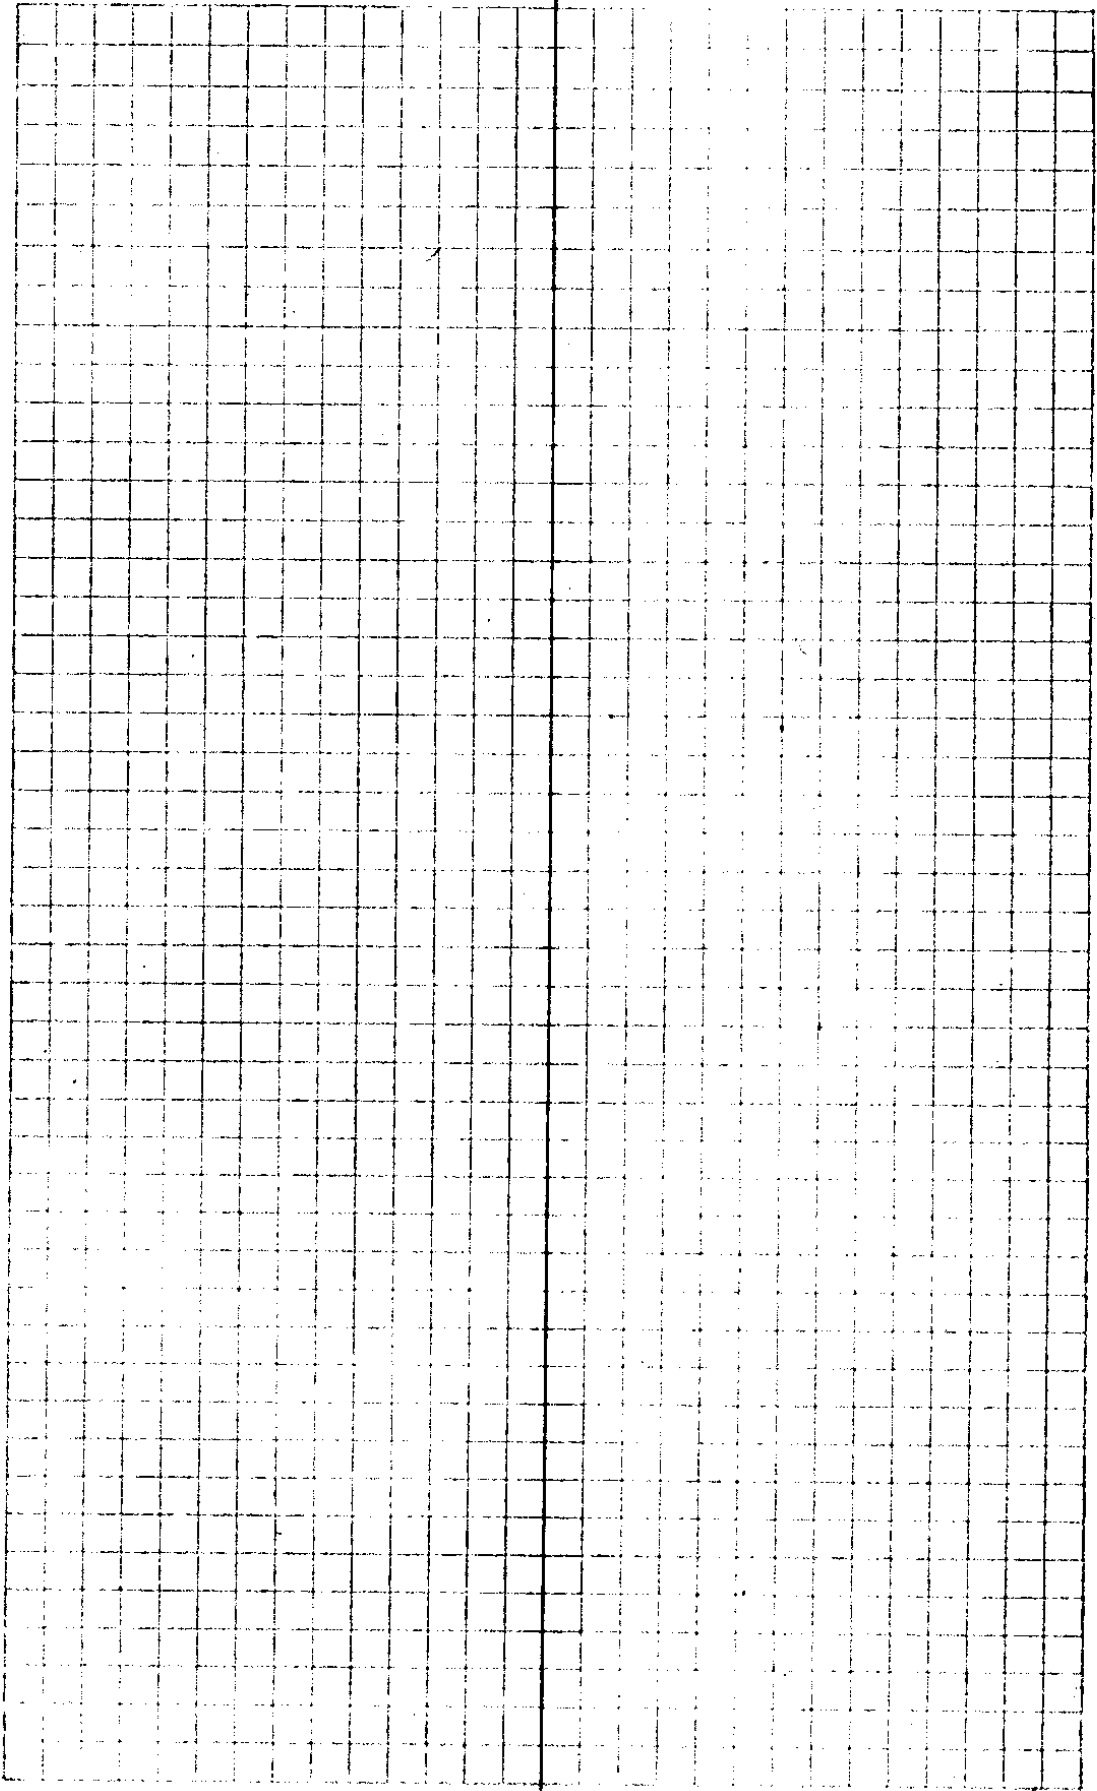

31/62

| Sta | + S | H I | - S | Elev | |
|------------------------------------|-------------------------|--------|------|-----------------------|--------------------|
| | | 708.11 | | | |
| EQ + Junction | | | 5.3 | 02.81 | |
| 2+48 | | | | | |
| 2+15 | Prop Sept T Siphon Δ | | 5.6 | 02.51 | |
| 1+85 | Prop Siphon Sept T. | | 5.79 | 702.32 | |
| 1+85 | Top Stake | | 4.87 | 703.24 | ✓ |
| | 2.66 | 705.90 | 2 | | |
| 1+23 | Prop Sept T #1 | | 2.80 | 03.10 | |
| 1+00 | Δ | | 3.8 | 02.10 | |
| BM - N Side Walk | | | 4.57 | 701.33 | |
| 1st Step Down - | | | 4.65 | 701.25 | 31.5' E of SW cor. |
| MENS TOILET | | | | | |
| FLOOR LEVEL | | | | | |
| 6" Vit Sewer = 0+02.5 = | | | 7.6 | F.L } 698.30 | |
| = | | | | 7.0 Top Pipe } 698.90 | |
| 7.3' N of N Edge Conc Walk (10 wd) | | | | | |
| 1" Water Pipe just over Sewer = | | | 6.25 | 699.65 | |
| To N. of Cen Bldg. | | | 4.62 | 01.28 | Girls Toilet F.L. |
| 0+10 Top Conc Walk N Edge | | | 3.05 | 02.85 | |
| 0+02.5 at Sewer | | | 3.2 | 02.70 | G.S. |
| Drain from Gym Showers | | | 3.92 | 01.98 | F.L |
| " " " | | | 3.4 | 02.50 | TOP PIPE |
| " " " | | | 3.2 | 02.70 | TOP Ground |

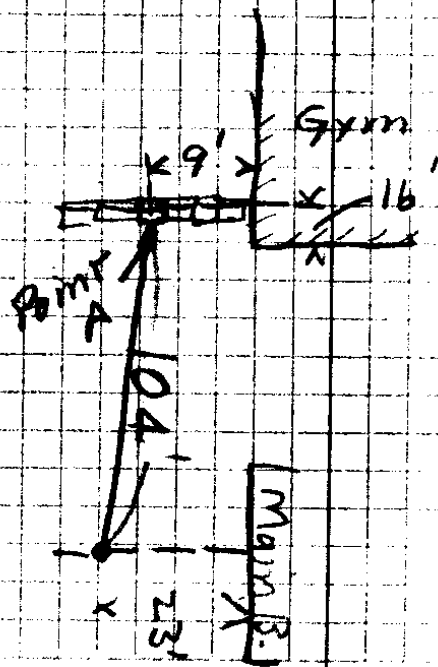

3/62

Aug-13-38
Boyer
Richardson