


30-40
31-63

Geo Luther Fitch
Dave Merritt

July 30, 1932

Witness
Ted Shellabarger

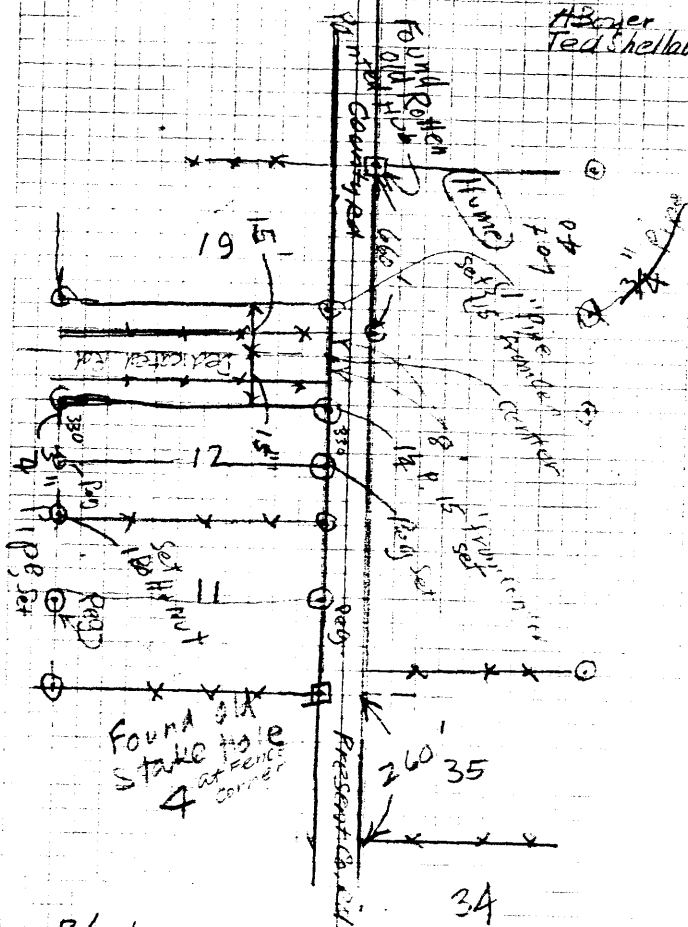

Plat D
Roseburg Tim Orchard Tracts
T 26 S
R 5 W
Sec 6

3A