


For } LV Fish
 } MK Emission

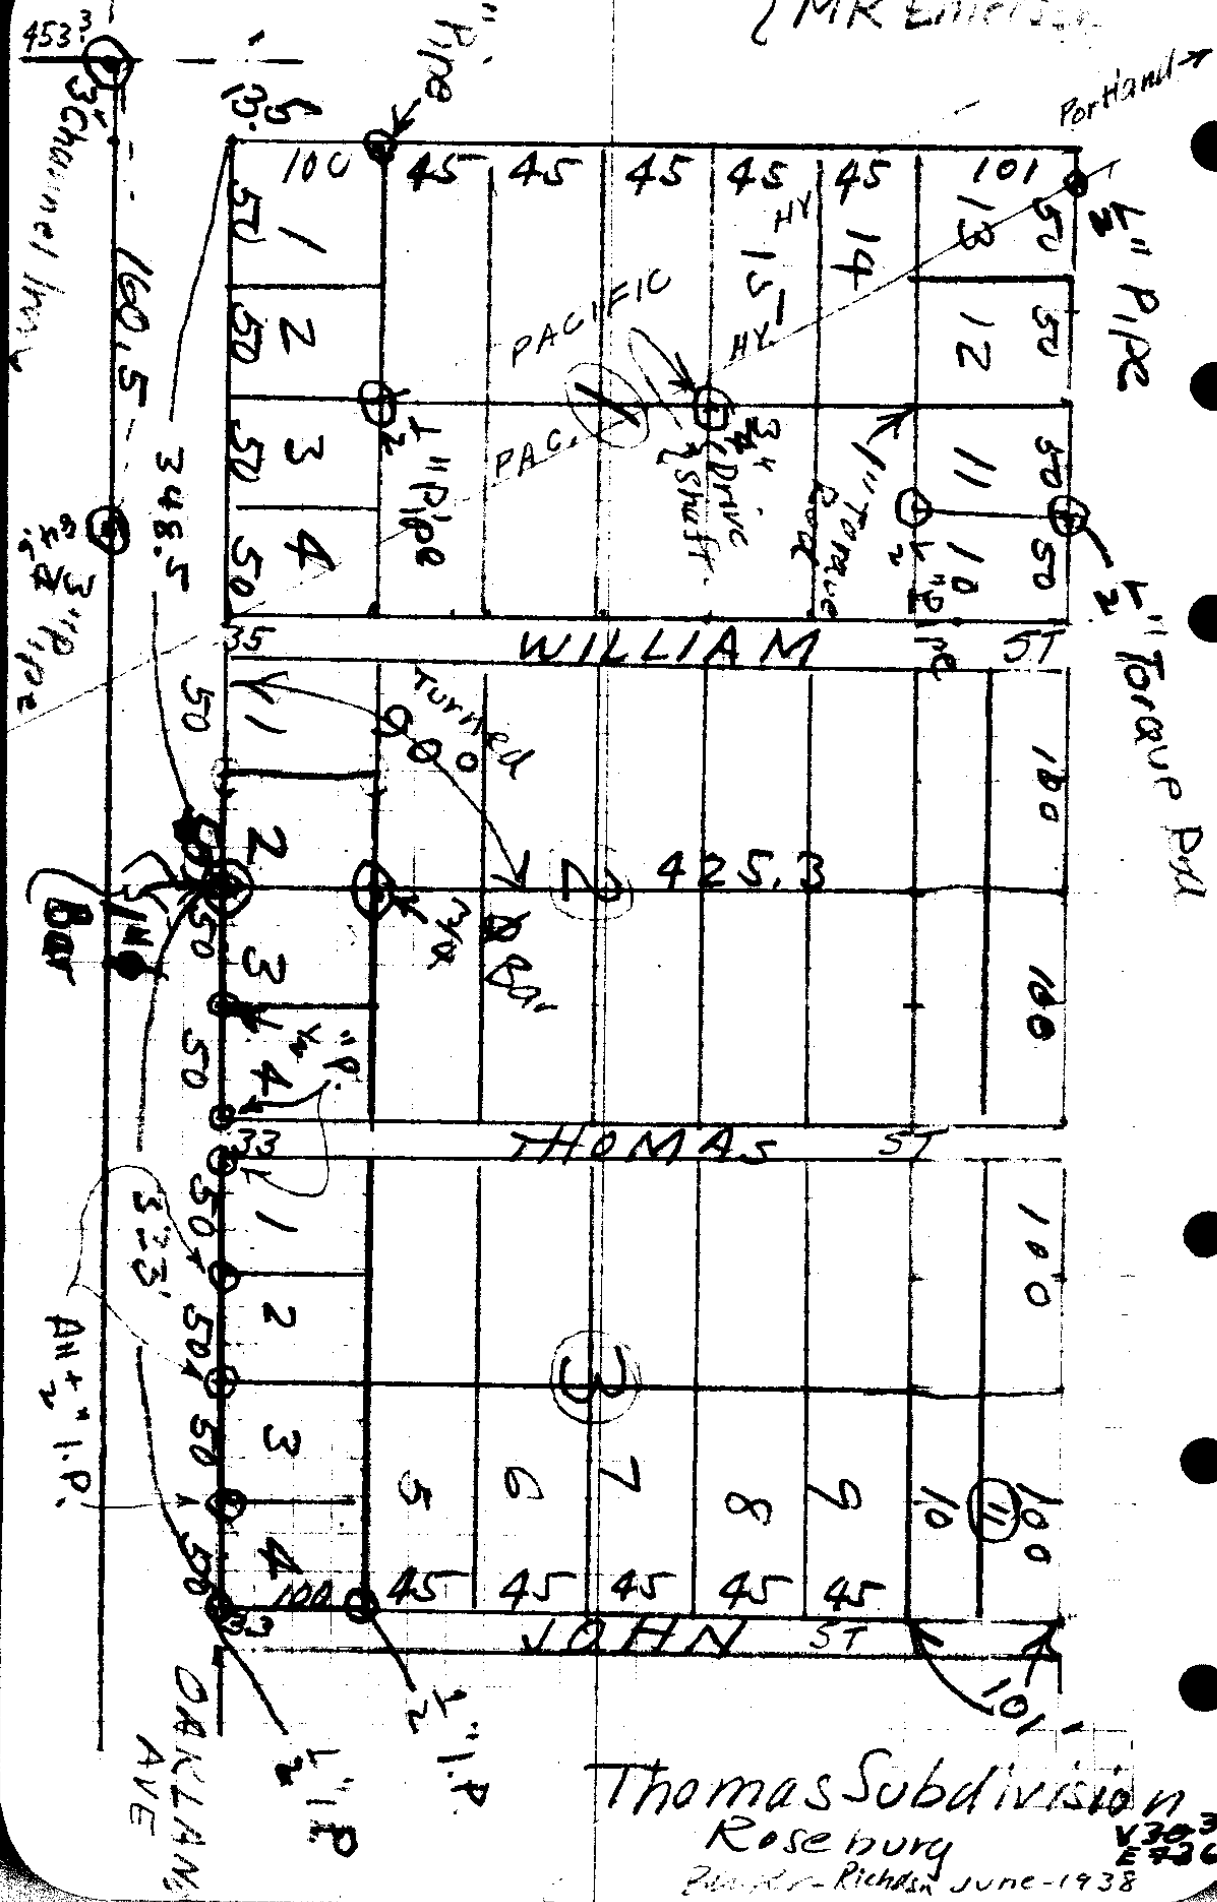

Thomas Subdivision
 Roseburg
 Richard - Richards June - 1938
 V3031
 E736

