


L.J. & W.R. NIELSEN PROPERTY
 ON LOOKINGGLASS ROAD, WINSTON, ORE.
 IN NW⁴NW⁴SEC. 21, T.28S; R.6 W; WIL. MER.
 NOV 1954 J.B. 1" = 50 FT.

AB, Feb-11-1944

Cor 16-17-20-21 1918 FCF

1" G.I. Pipe
 48" B.O. S 11 1/2° E 200 L

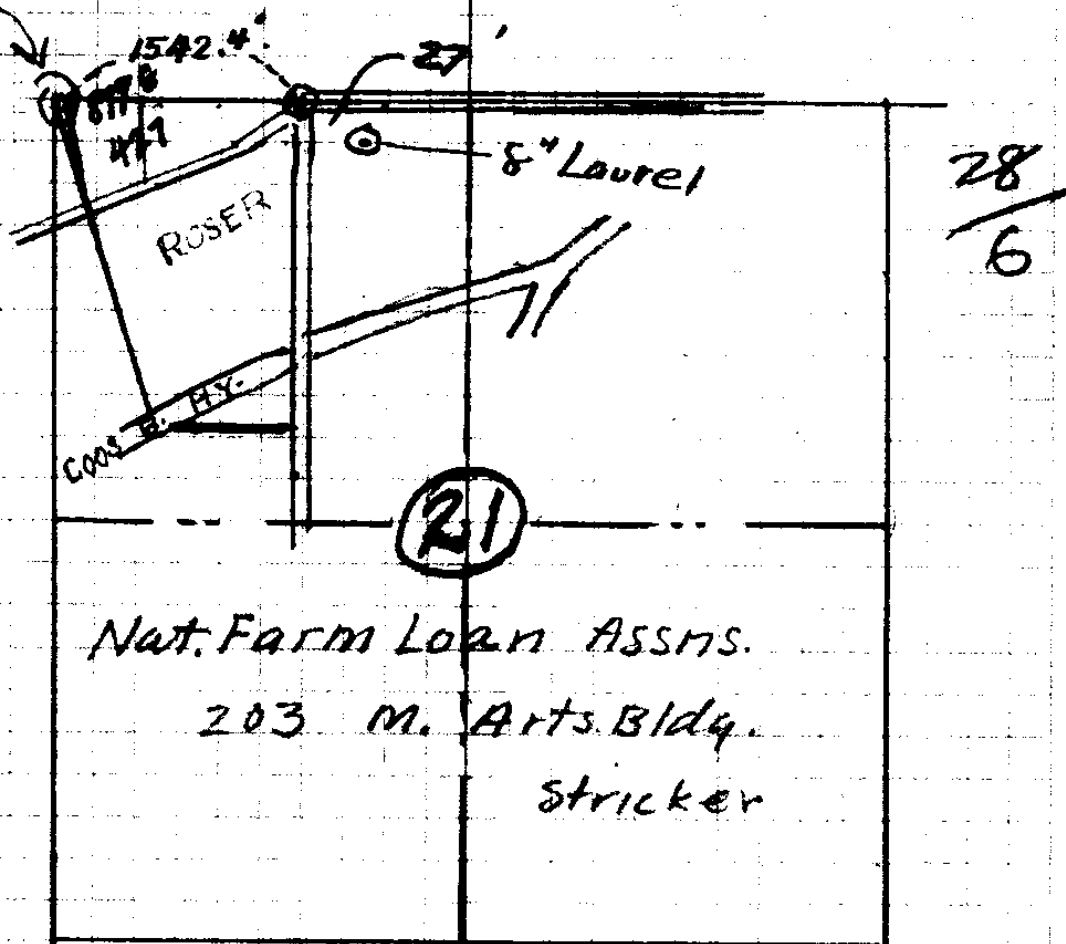


Nat. Farm Loan Assms.
 203 M. Arts Bldg.
 Stricker

Lot 1, B. B. Brockway Estate ⁹⁹/₉₂
 Beg. 1.58 ch. E of SW cor sec 16, 28/6

th. S 15° E. 2589 ch. = 1708.7
 E. 16.67 " = 1100.2
 N. 25.0 " = 1650.0
 W. 23.37 " = 1542.4

1.58
 6'
 948
 448
 10428

6
 7 8 9 10 11 12
 1517 1615 1413
 14 20 21 22

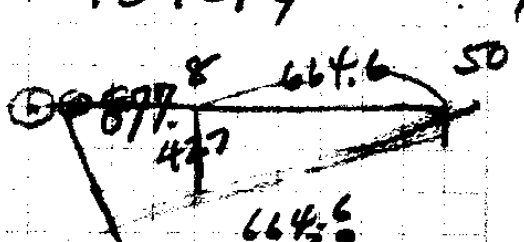

32/44

427
 56
 2 477
 239

664.6
 239
 598.6
 1093.6
 15292
 158839.4 = 3.6 Ac.

CS FILE FOLDER

CONTAINS

MORE

INFORMATION