

32/62  
~~BUTTS~~

Earl Kennerly  
State Police

All Lot 14 + 1/3 Lot 13 B123

Waites

ST MUN  
FOUNDA  
180° 09' 30" CRK

Found Monument


Found ST MUN.

30  
80  
50.33  
160.33

20  
50.33  
3.33

3/40  
13.33' 25  
40 80  
53.33' 105

May 2-1944

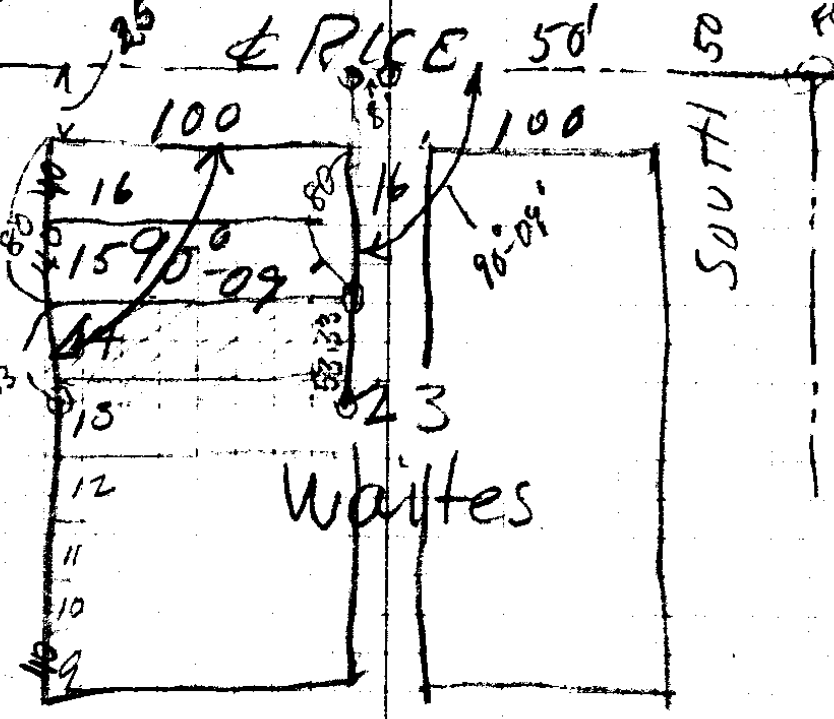

P C.S. 32/62