


5/2/26
E.P.P.

Set Ford A1e
A 90' B.A. ? 56° E 5 24

Set 4x4x 3' cedar
6 1/2' B.A. 59 2' W
15' B.A. 55 1/2' E

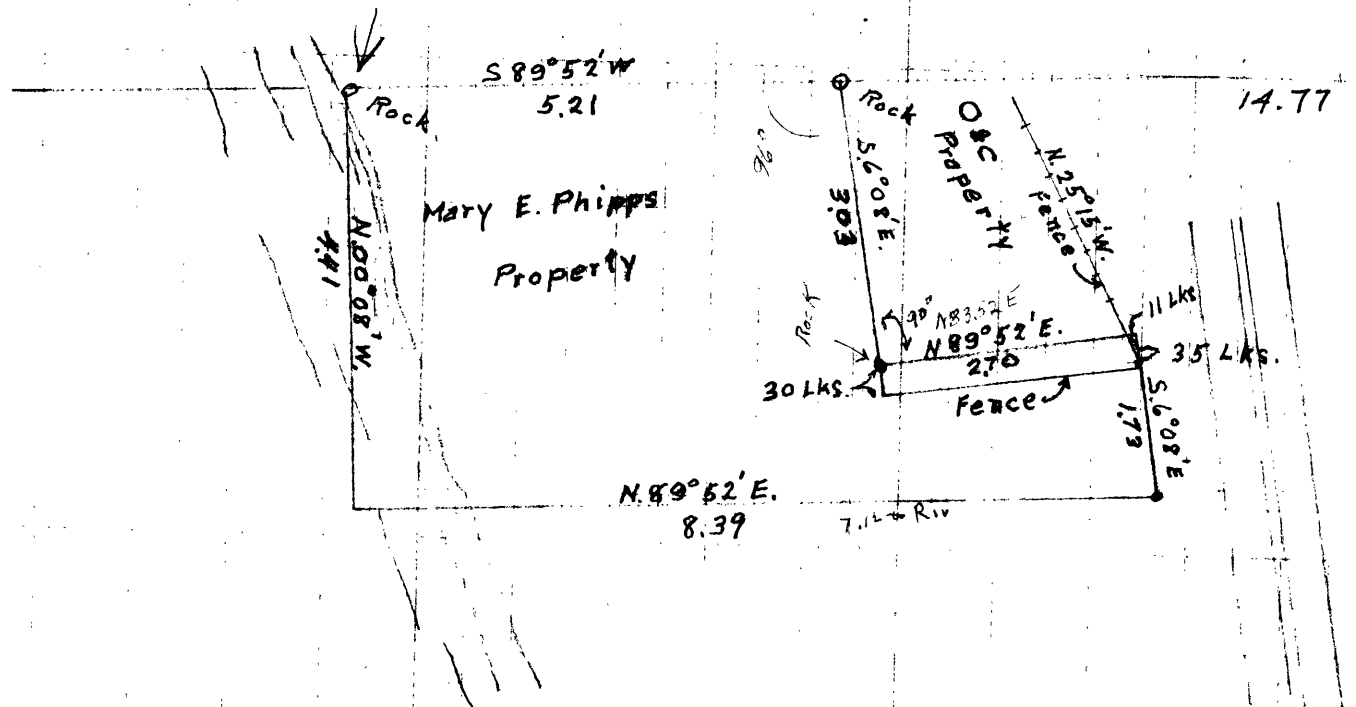

29	28
32	33

This is on wrong side RR
for Griswold Property.

F. Book 37 p 935