


Cribbins Myrtle Pt.
Transit-

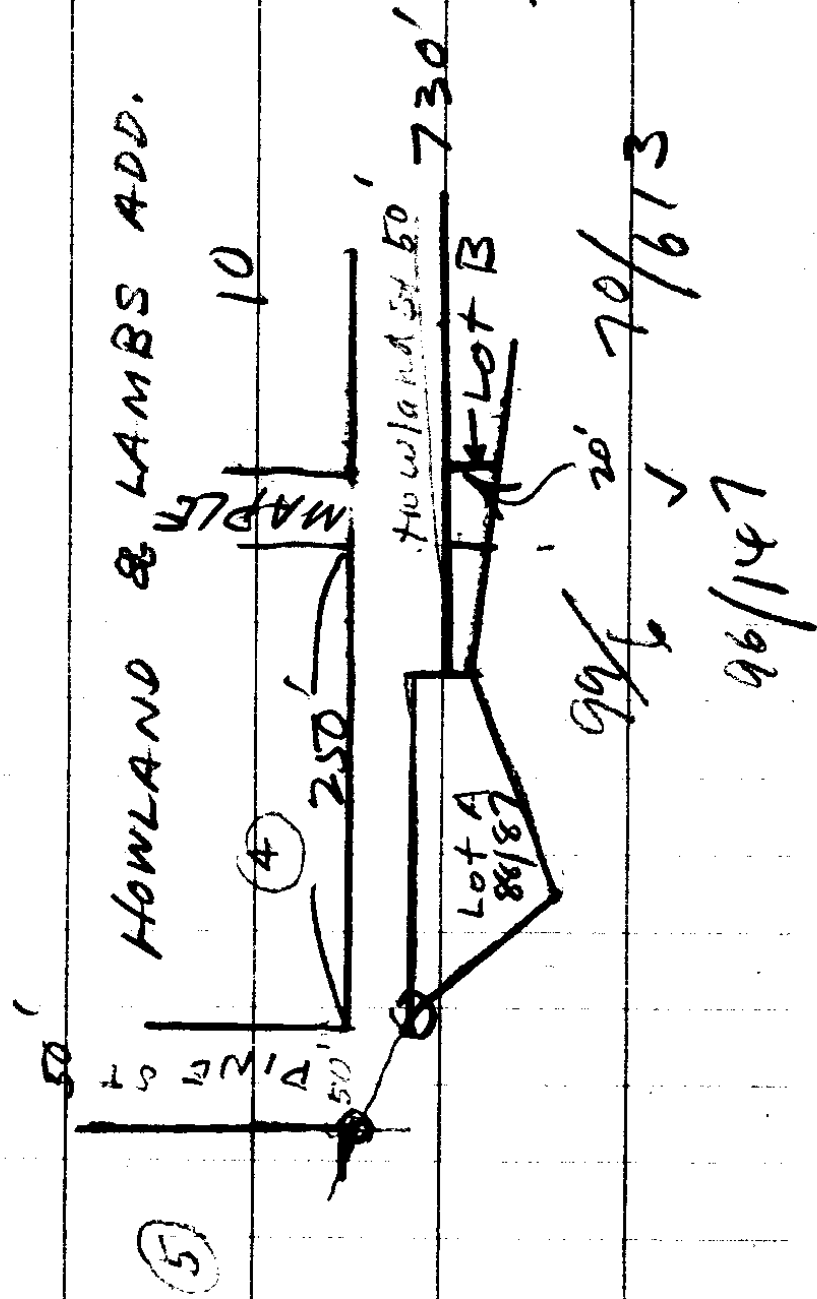

Nov 27 Myrtle Cr.

F. H. A.

20 mi one way

2500⁰⁰ ~~white~~ ~~land~~ House

500⁰⁰ Barn

3000⁰⁰ HS + Barn

CS FILE FOLDER

CONTAINS

MORE

INFORMATION