

~~Sec 75~~
~~26~~ 7 785E
~~Trussle~~
 Paul Bliss

n curvy Esn.

Plat C

Plat C
n curvy Esn

Best Lat 14 + 16

16 = corner


Linear E side 16 wanted

105 / 78

25" W.O
 556W 59.7
 521W 93.0

For Mr Wimer, Co. C.O.P. Co.

July 12, 1944

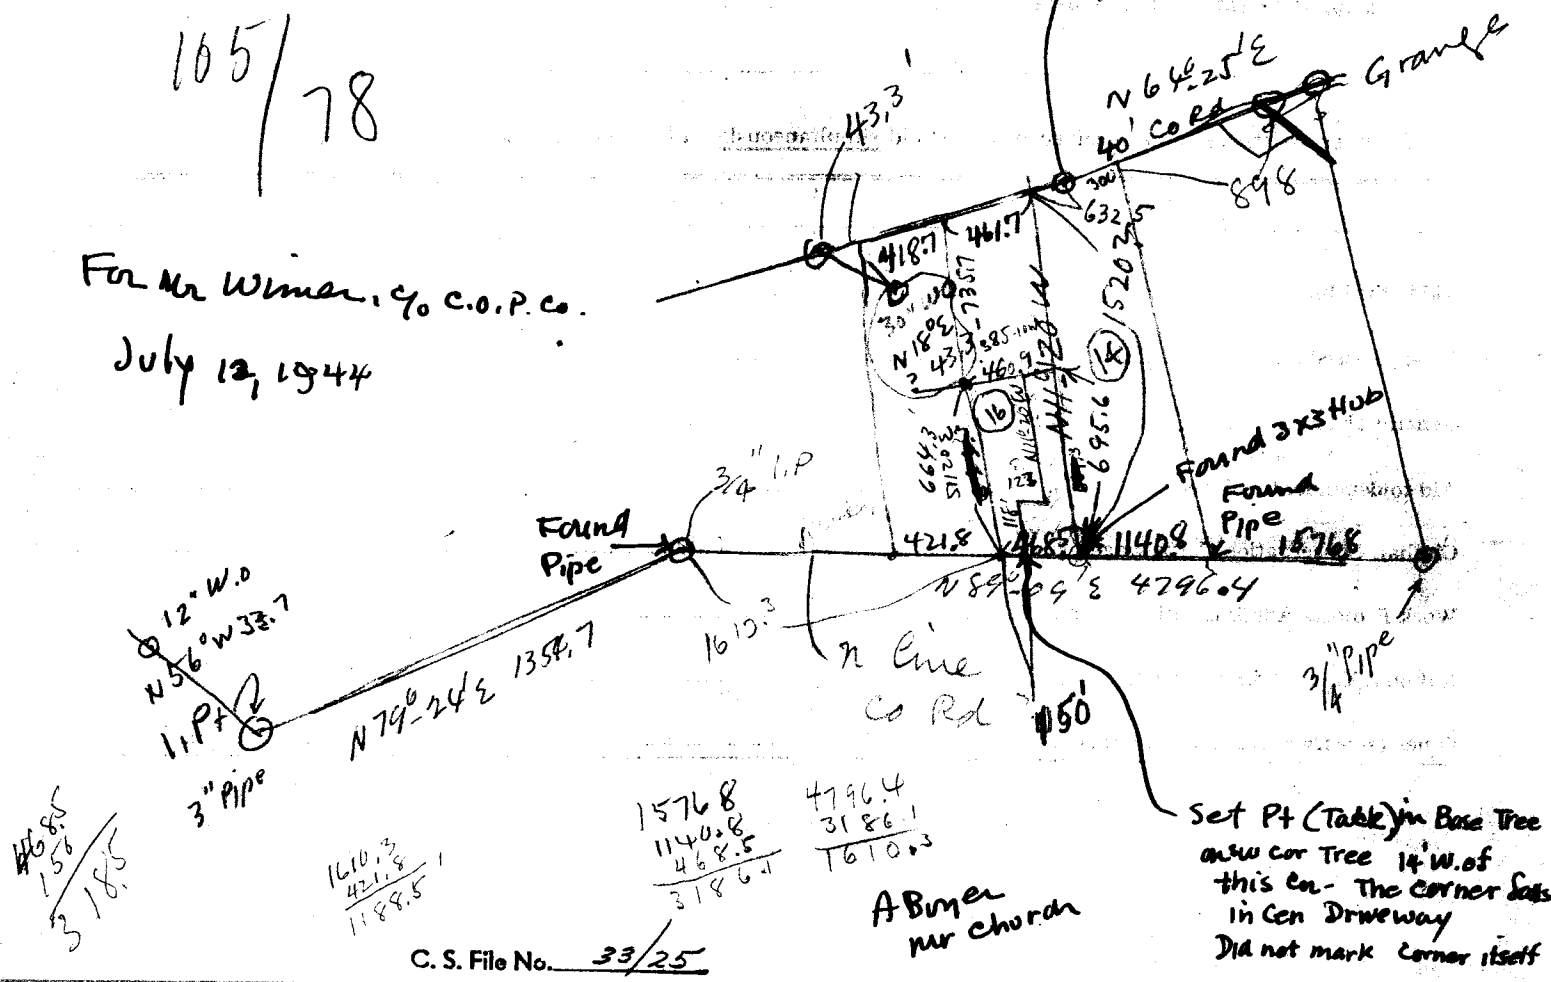

468.5
 156
 318.5

1610.3
 421.8
 1188.5

1576.8
 1140.8
 468.5
 3186.1

4796.4
 3186.1
 1610.3

A Bimer
 Mr church

Set Pt (Tabk) in Base Tree
 on W cor Tree 14' W. of
 this cor - The corner falls
 in Cen Driveway
 Did not mark corner itself