

11" tree
MARKED B.T.
A 1/2" iron
bolt

parallel
parallel
57°36' W


A 2" x 30" iron
pipe set 20" in
ground


from which
370' E
52°30' W

1/4" x 24"
IRON Bolt
462.0
519.041' W

16" = 91
iron
rod
power pole

12" x 2" Blaze
on N.W. side
A 12"
CATALPA
TREE

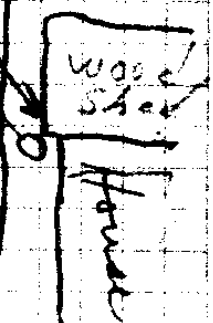

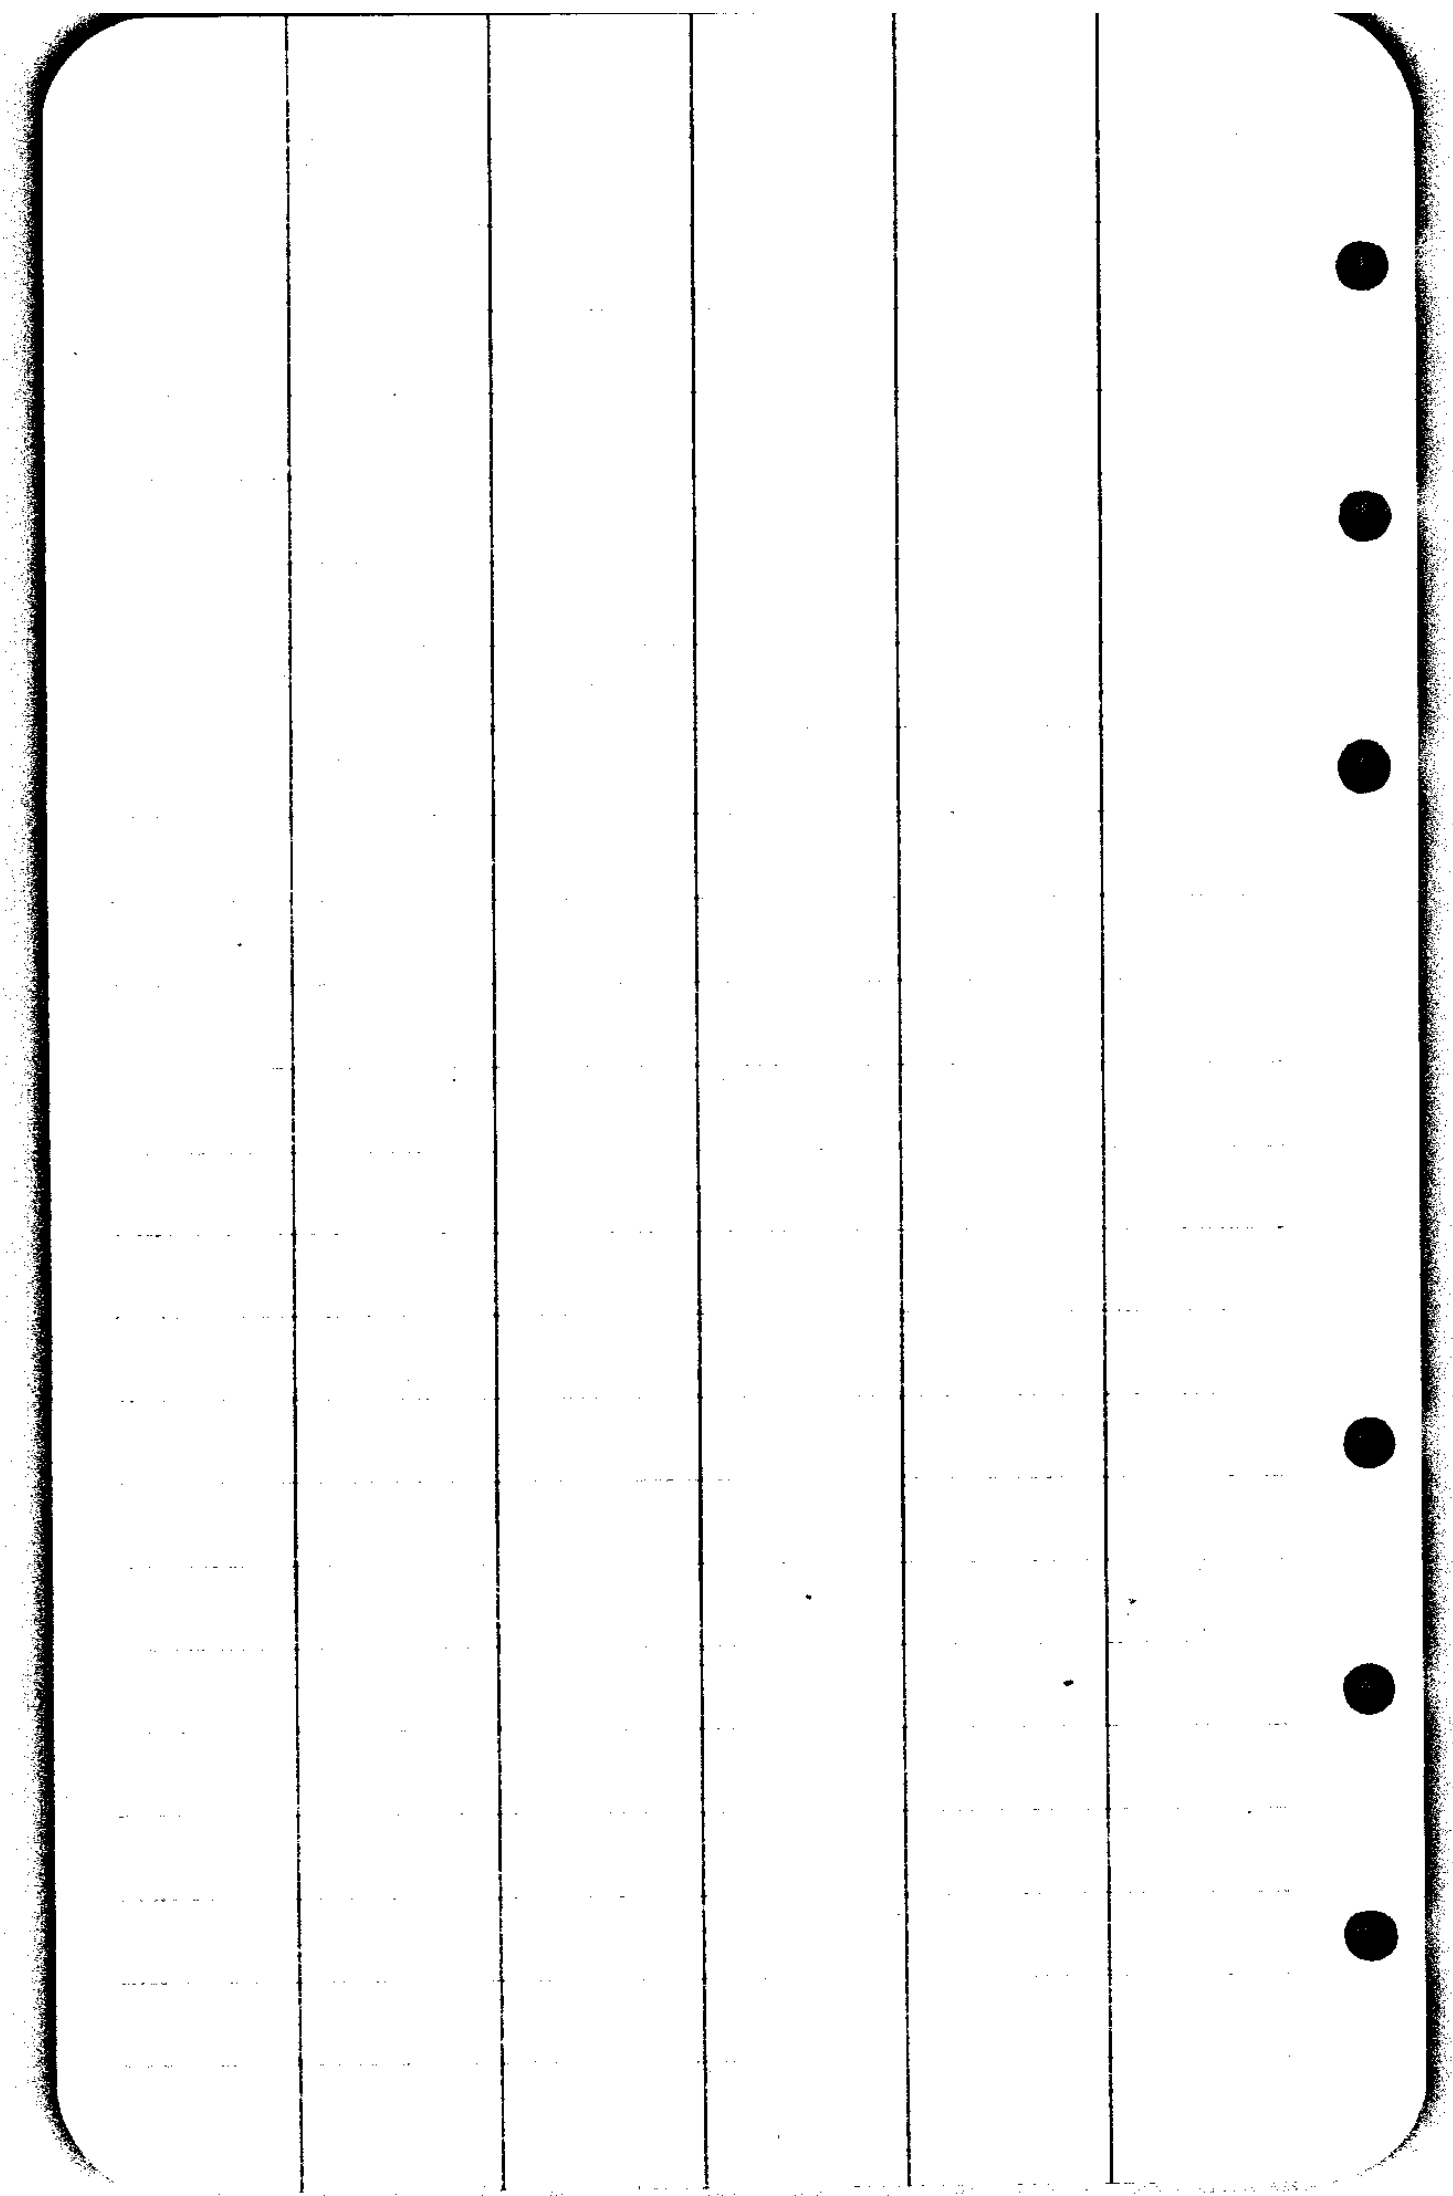

OCT 5
1944

Diamond Timber Corp

Sta	+S	H I	-S	Elev.	
	7.84	107.84		100.00	
			3.84	104.00	Final W.S. Elev.
	7.20	107.20		100.00	
			3.20	104.00	Final W.S.