


KINNEAR⁵²

52

NW

40

30

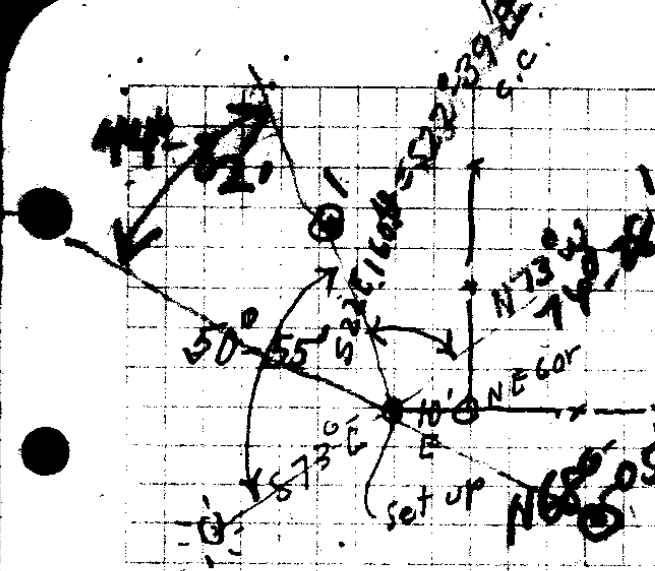


July 28

9:11:00 A.M. S.T.

Vert 43=10'

$S 73^{\circ} 10' E$ to Sun

Set up at pt 10' E of NE Cor. Lex Inv Co

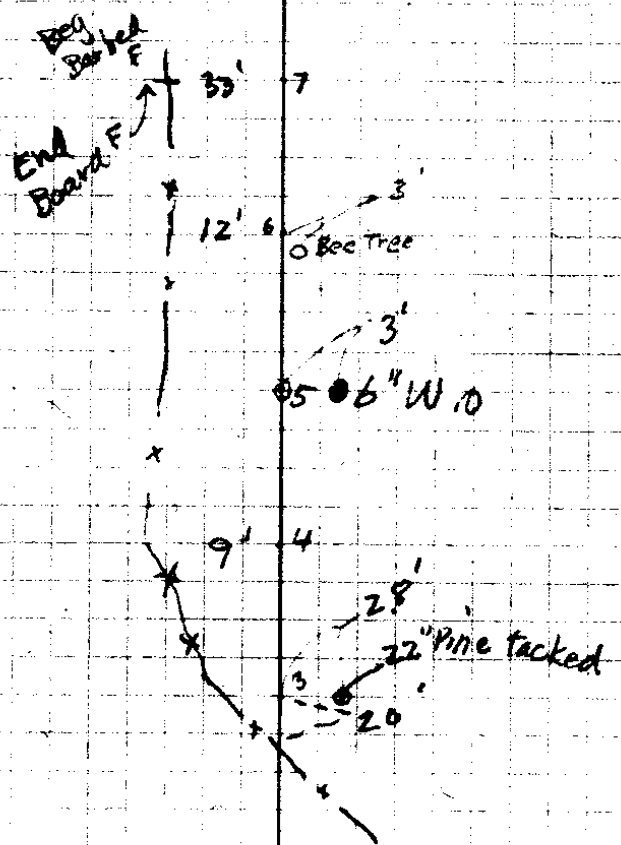


33/04

57.8 SE Cobb
NE La Cobb (3)
8-10

34
62.8
118.8
4.8

102.7
97.0
718.90
9243
99,619.0

34
62.8
118.0
2148

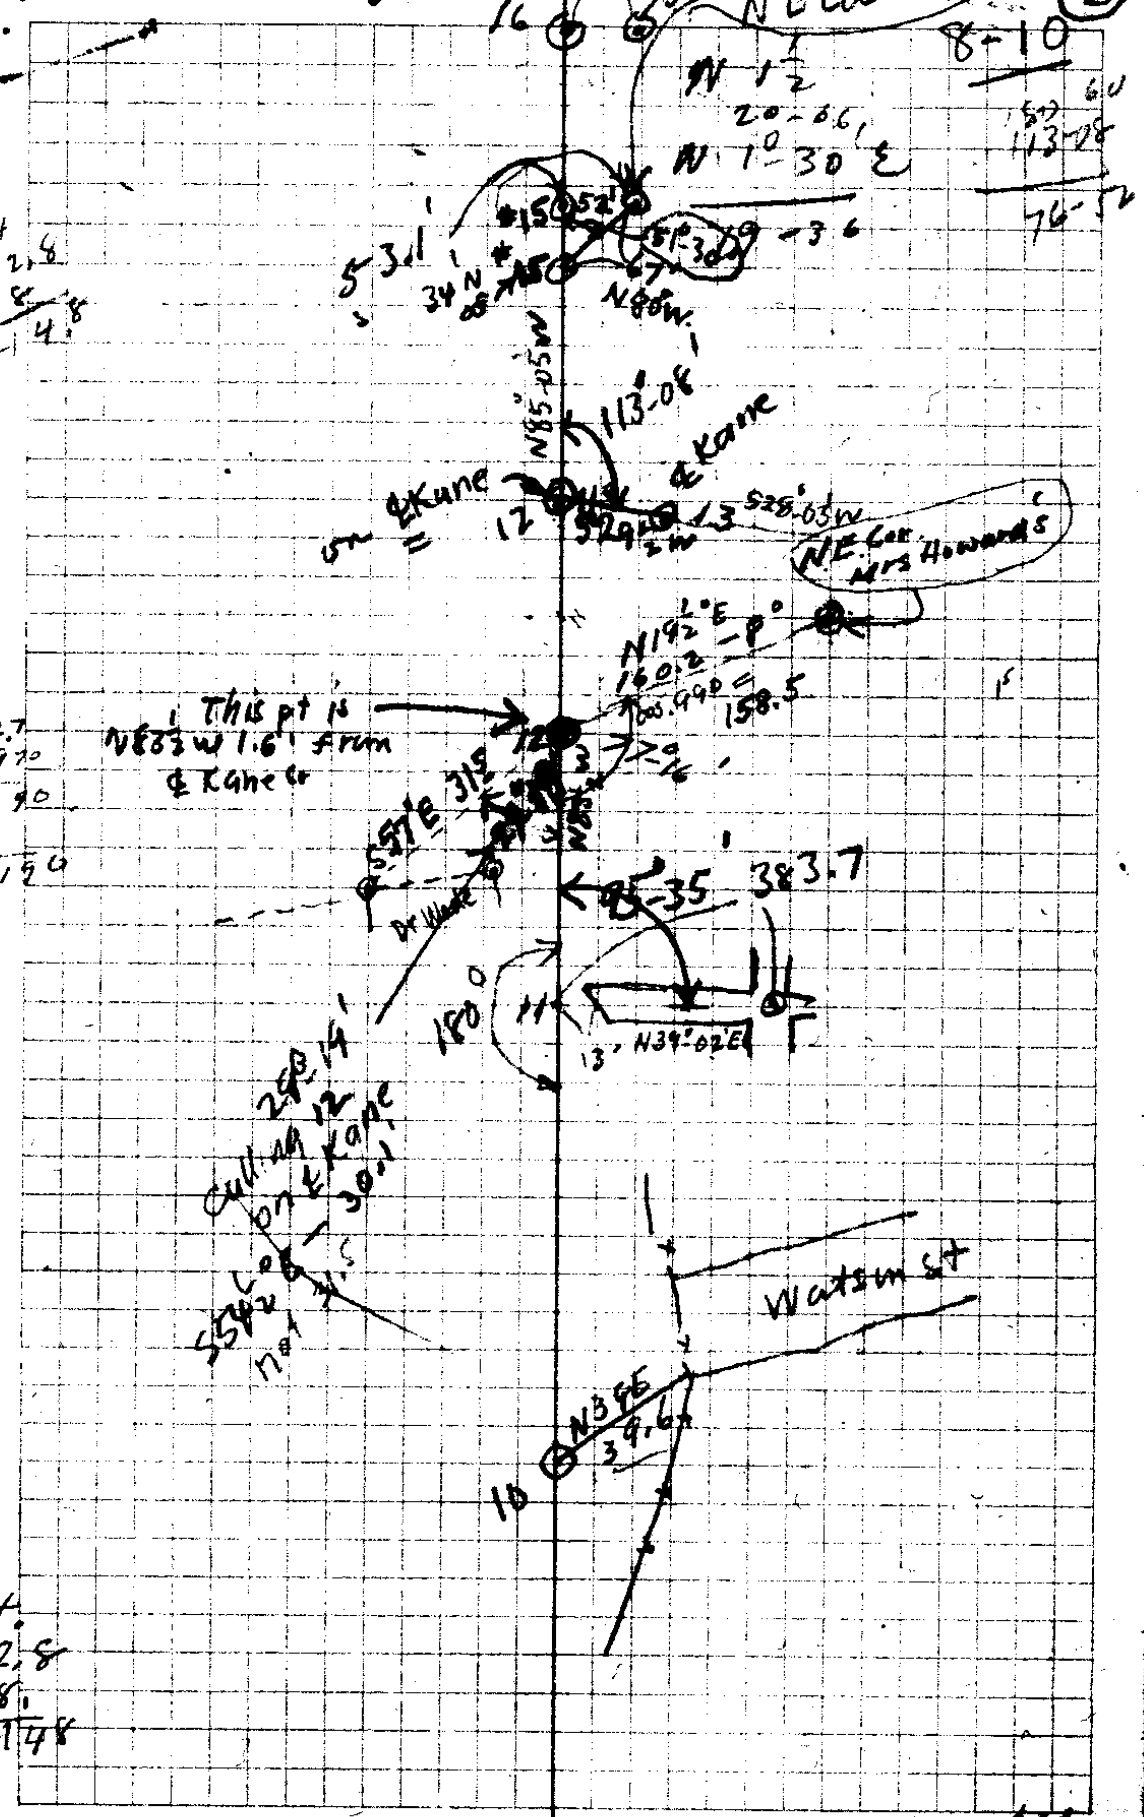


Hughes 118 on
inside Kane

A 645 SW 202

Y 118 16
2

576

163
NE Hughes
= Rich Wilson

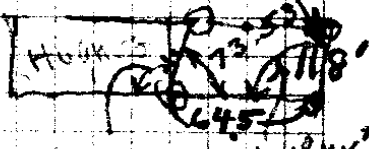


11.26


121-44

S. File No.


32/44

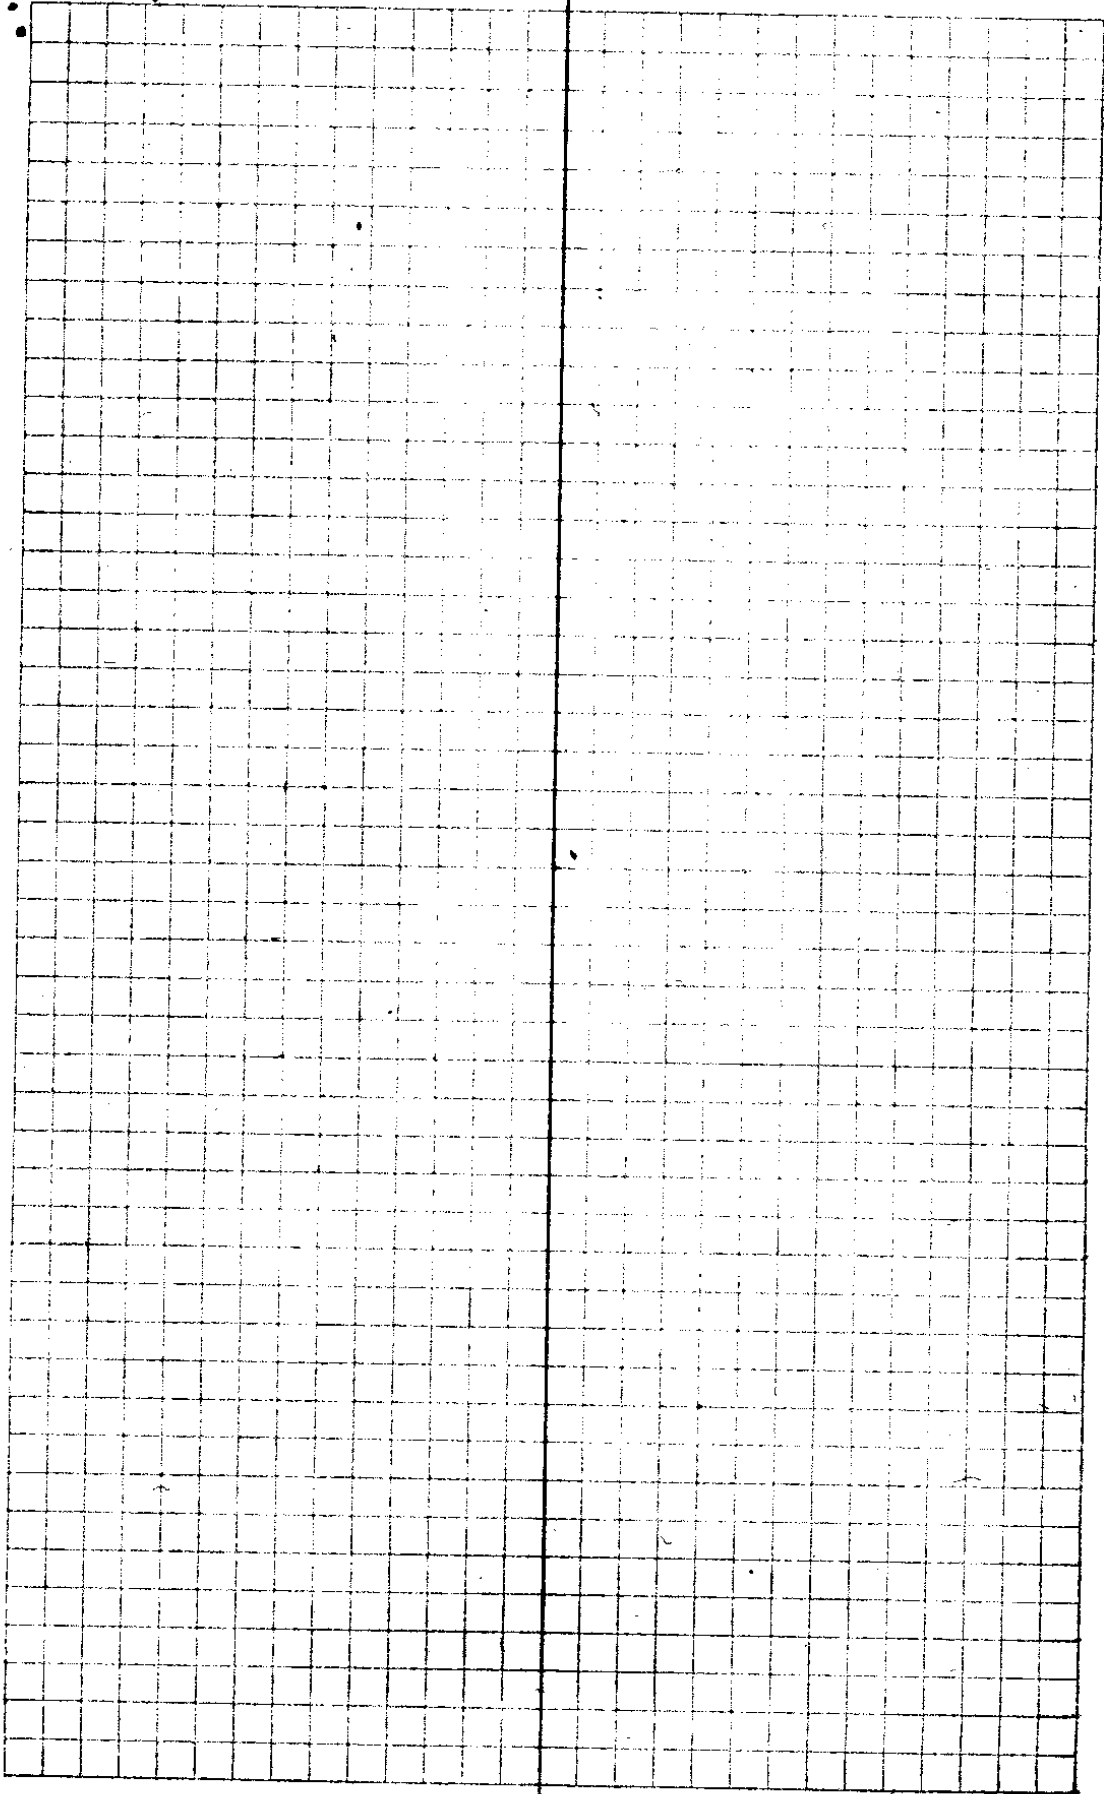

C. S. File No. 53/44

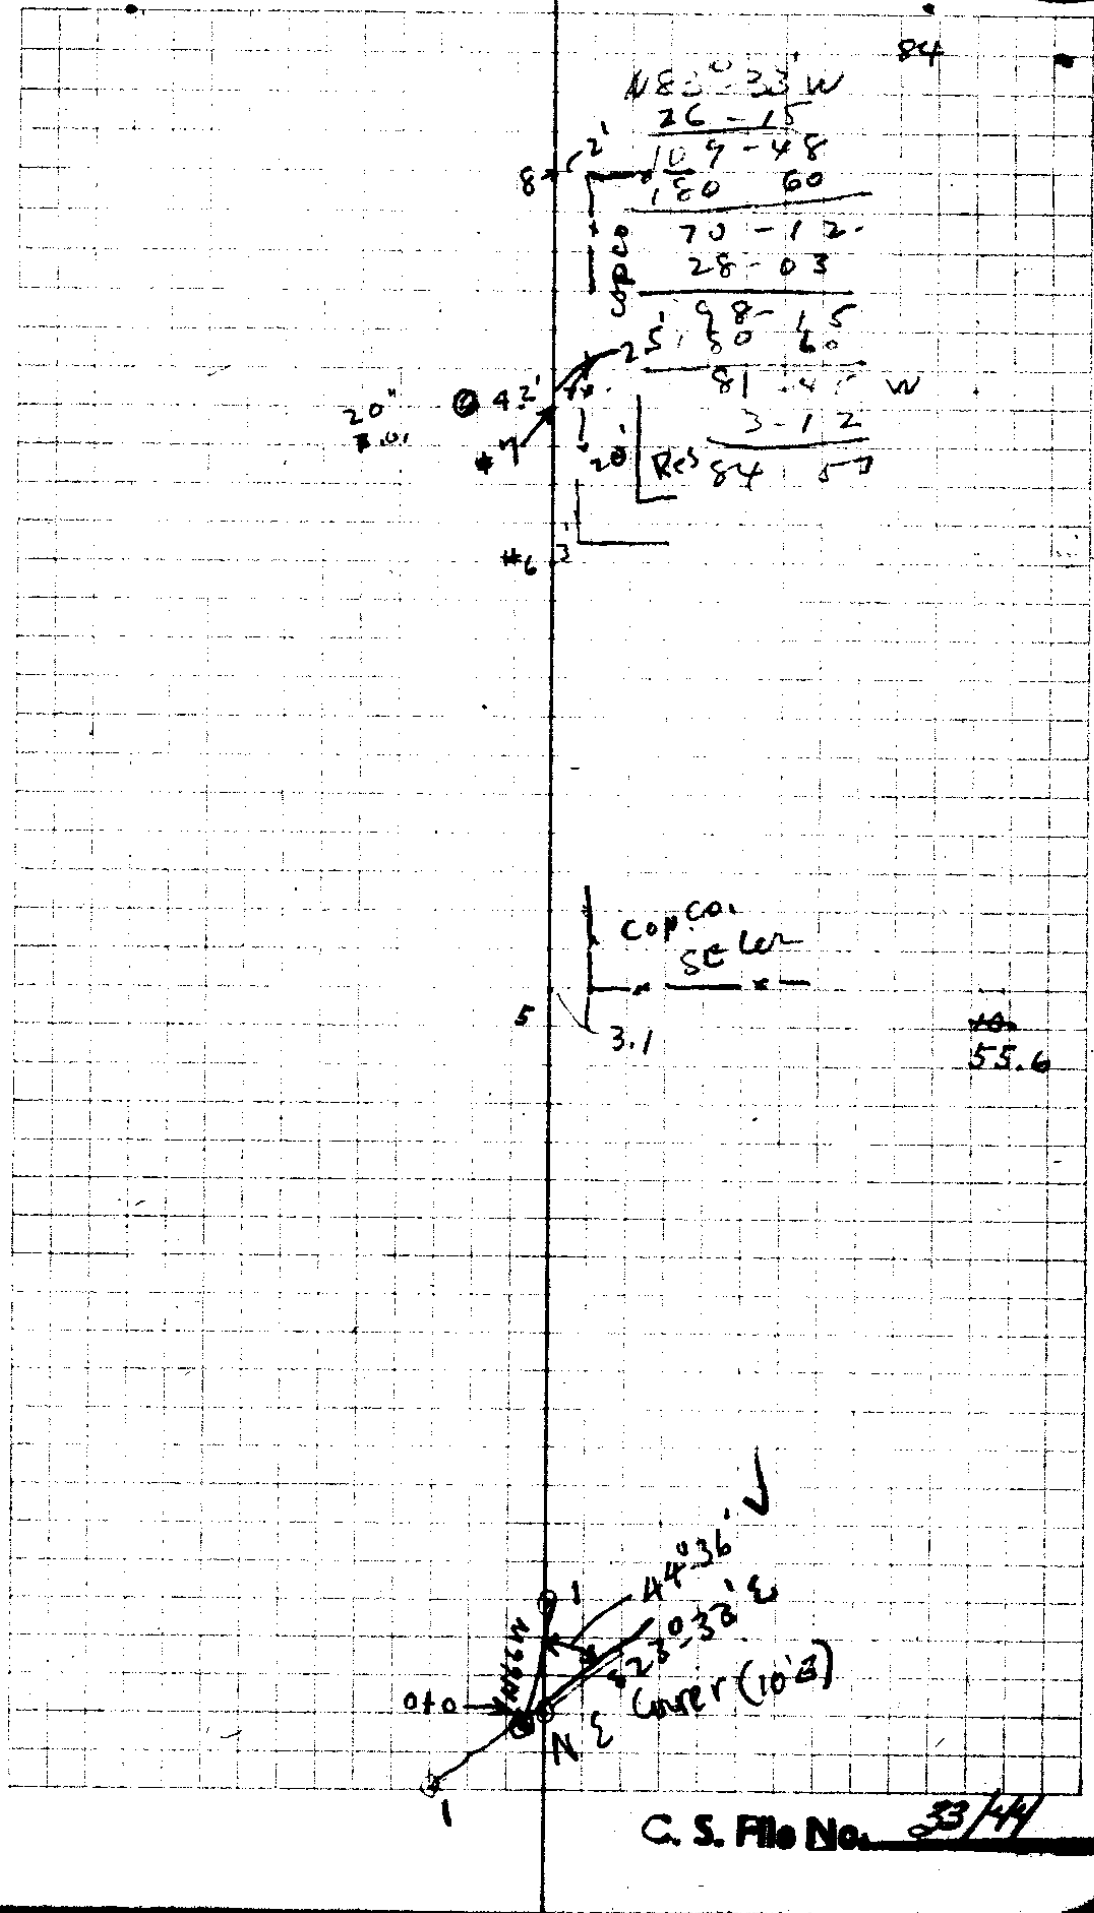

C. S. File No. 33/44

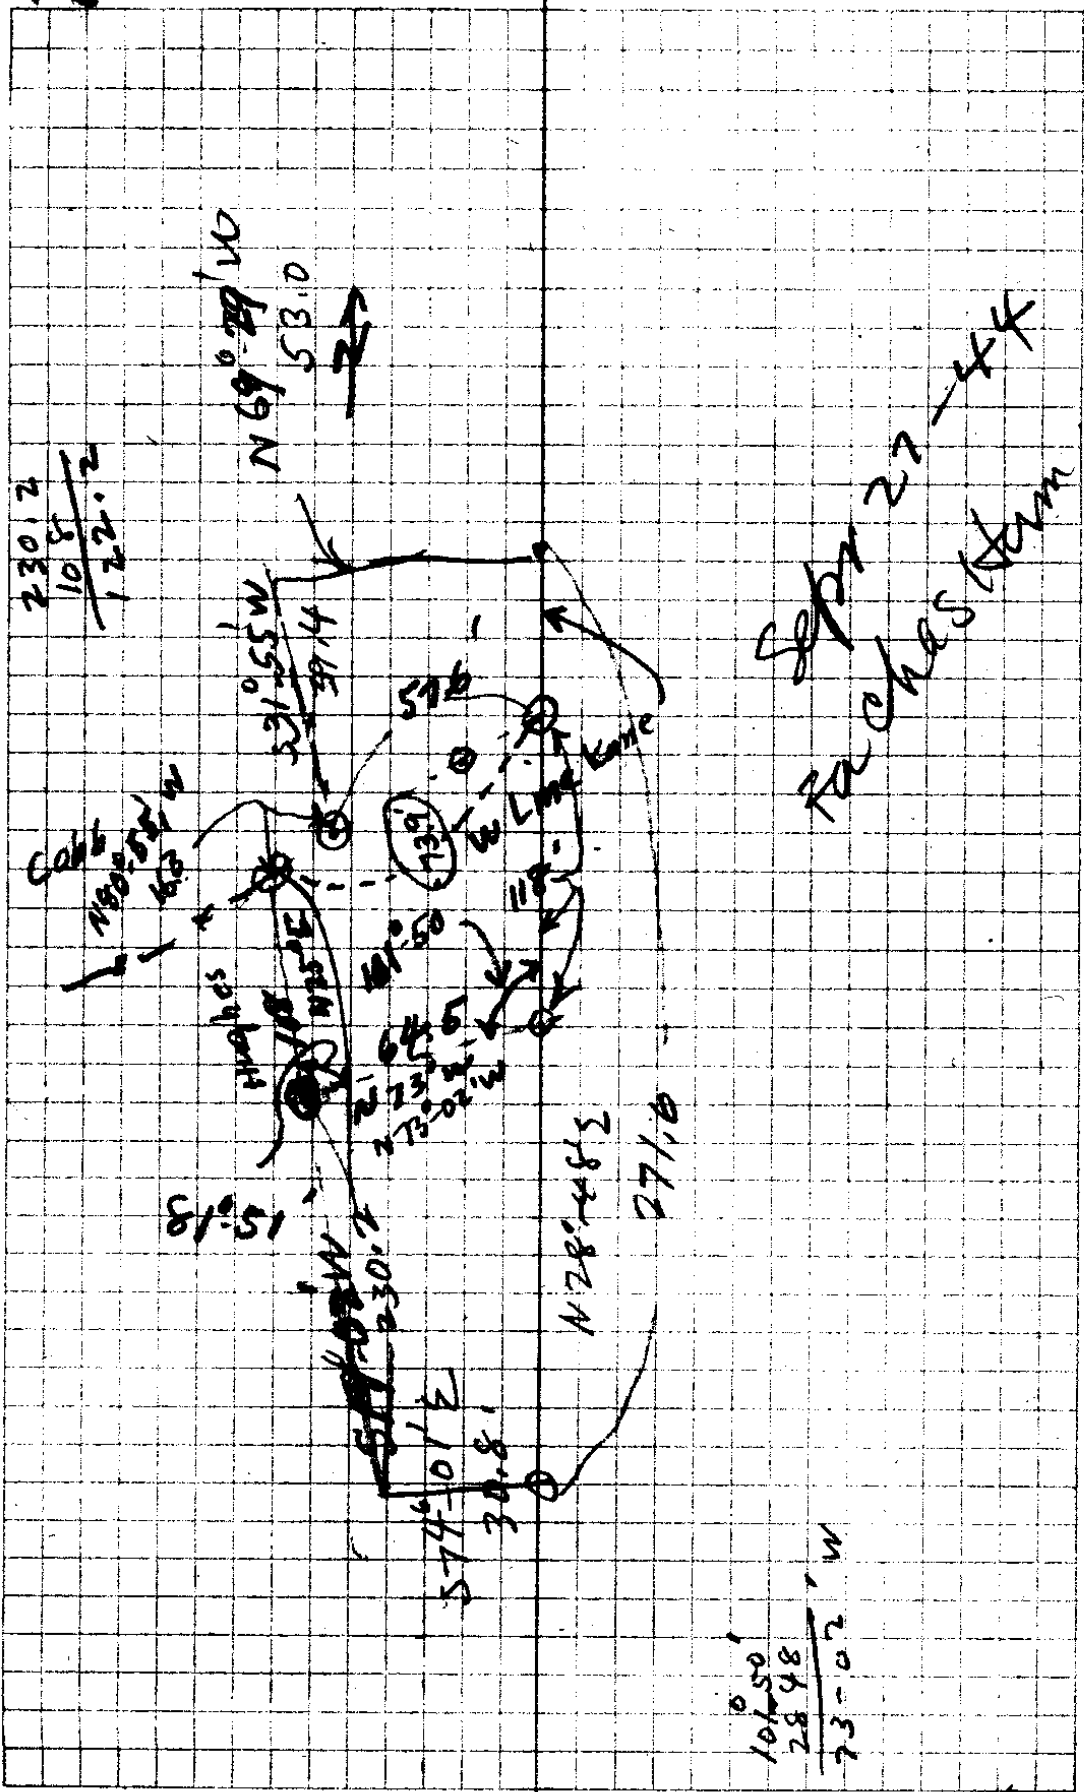

C. S. File No. 33/44

CS FILE FOLDER

CONTAINS

MORE

INFORMATION