


S. File No. 34112

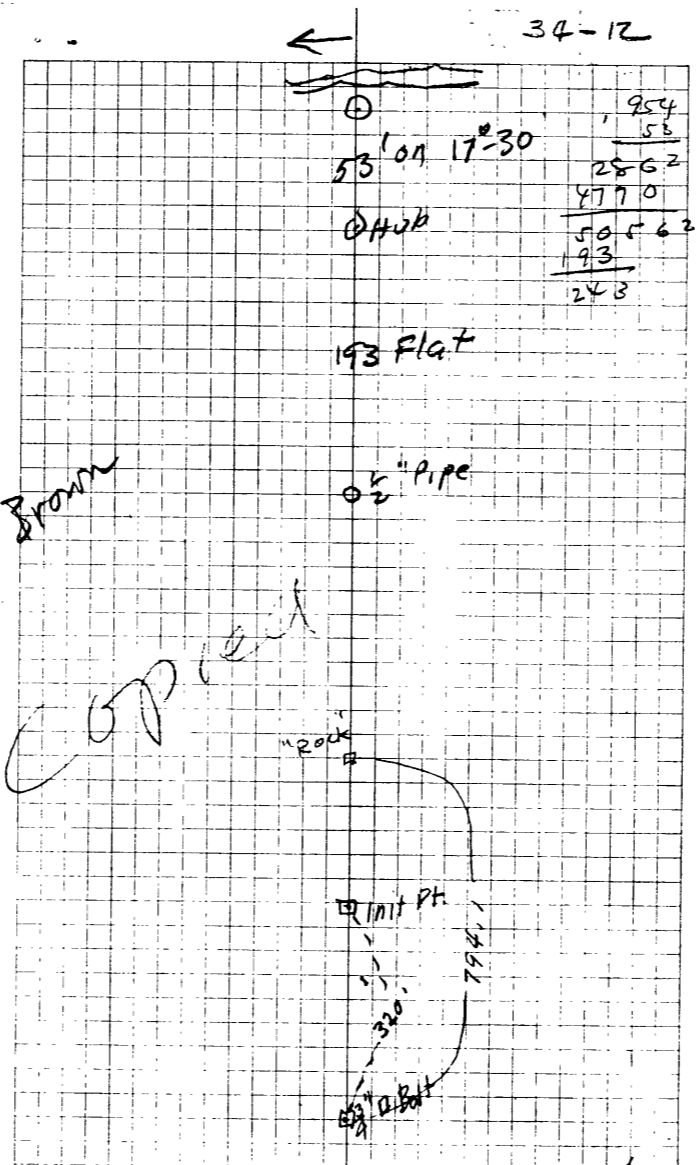

C. S. File No. 34112

	Geo Vaughn	Aug. 21
		1940
		AB
8	912.21	
7	99.6 13°30' 972	968
6	125.0 14°00' 970	121.2
5	120.6 15°30' 963	116.1
4	138.2 12° 978	135.1
3	110- 13°45' 971	106.8
	141.3 F 978	141.3
2	N 107.9 F	107.9
1	S Side RA	
	N 2-23 87.0 F 87.0	
	TRACT 37	

} Did not use this

S. File No. 34112

24
66
124
1584

34-12

87
107.9
141
110
138
583.9

87
107

87
107.9
141.3
106.8
135.1
116.1
121.2
96.8
979.2

54/12

File No.

Aug 21

357
2215
13.42

1940

114.5
152.
11.9
59.3
414.8

8
7 N 59.3
W 129.119
6

N 152.0
N 114.5

N 5
R 5

N 46° W 268.5 N 47° 28' W

N 5
R 4
Δ 5° 30' L

N 41° W 8,995 N 41° 53' W

N 5
R 3
Δ 16° 20' R

N 58° W, 389.0 F N 58° 13' W

N 5
R 2
Δ 9° 55' L

N 48° W 102.4 F N 48° 18' W

1 Δ 50° 45' L

N 2° 27' E 87

NW Cor 37 = Tract No 37