



24' St Chap

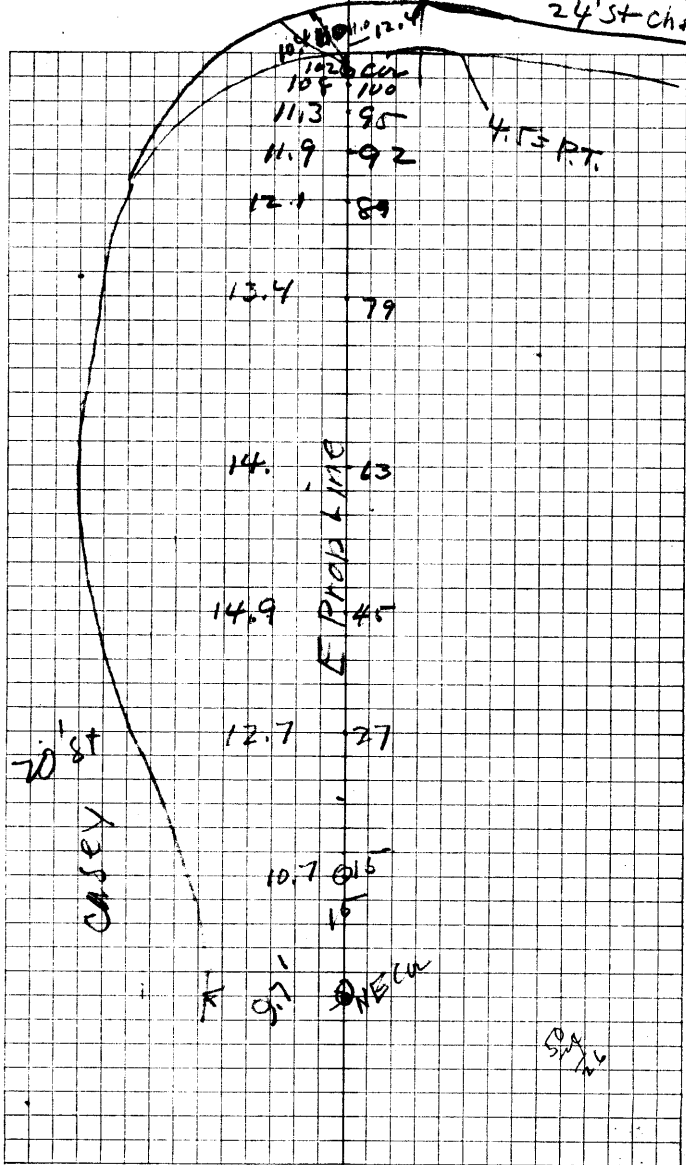


34-34



C. S. File No. _____

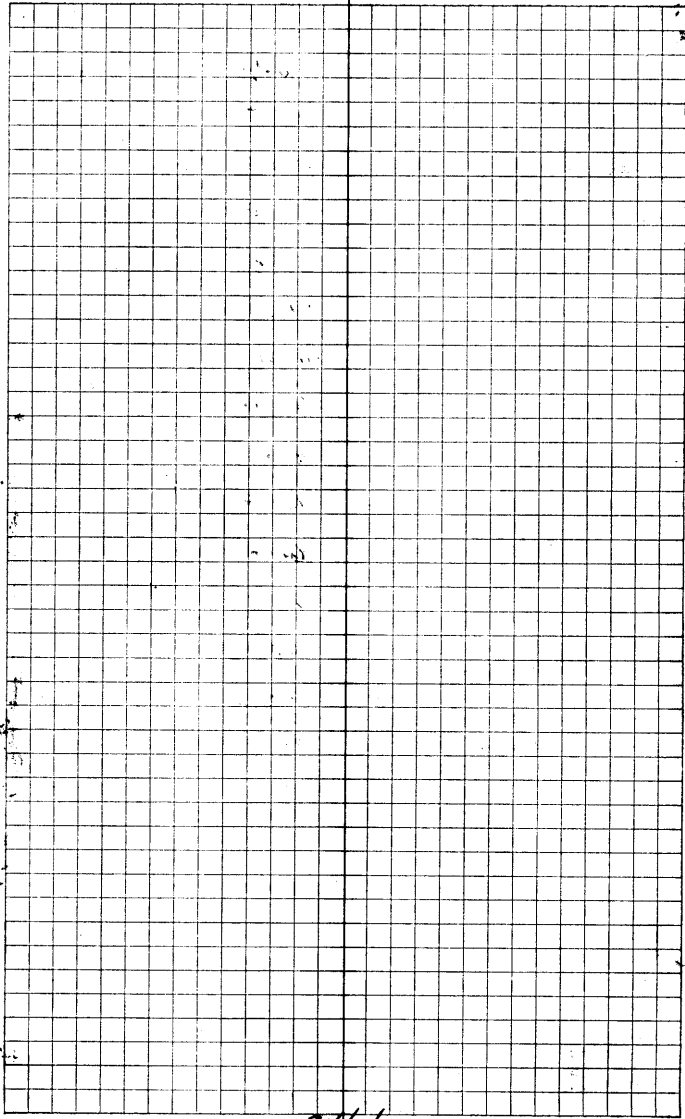

S. File No. 34/34

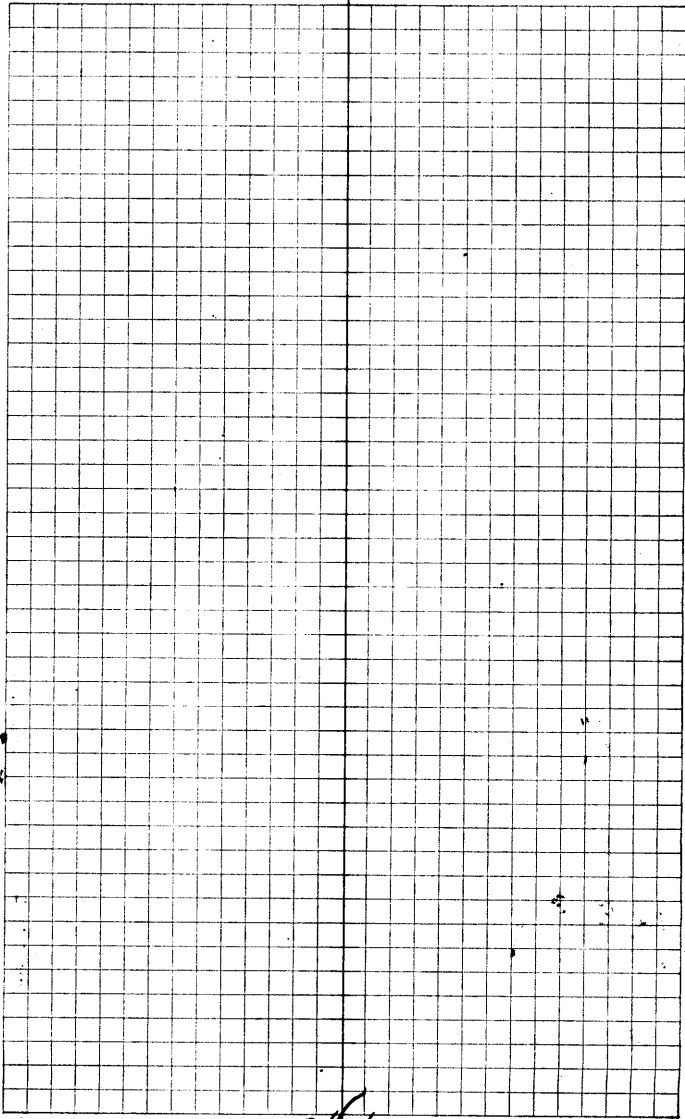


File No. 31/31

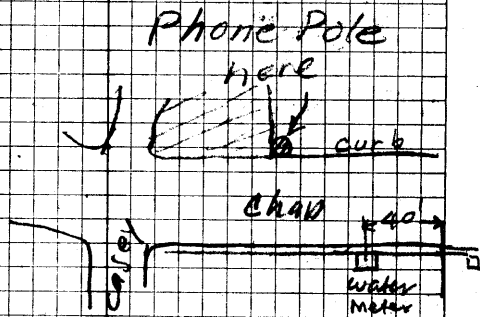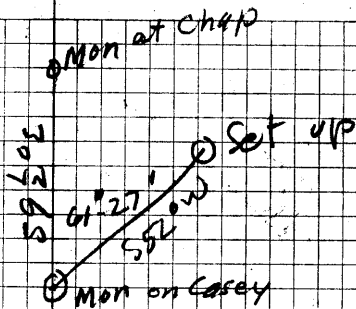

12' Prop Line to
 curb Chap

10' Prop Line to
 curb Casey

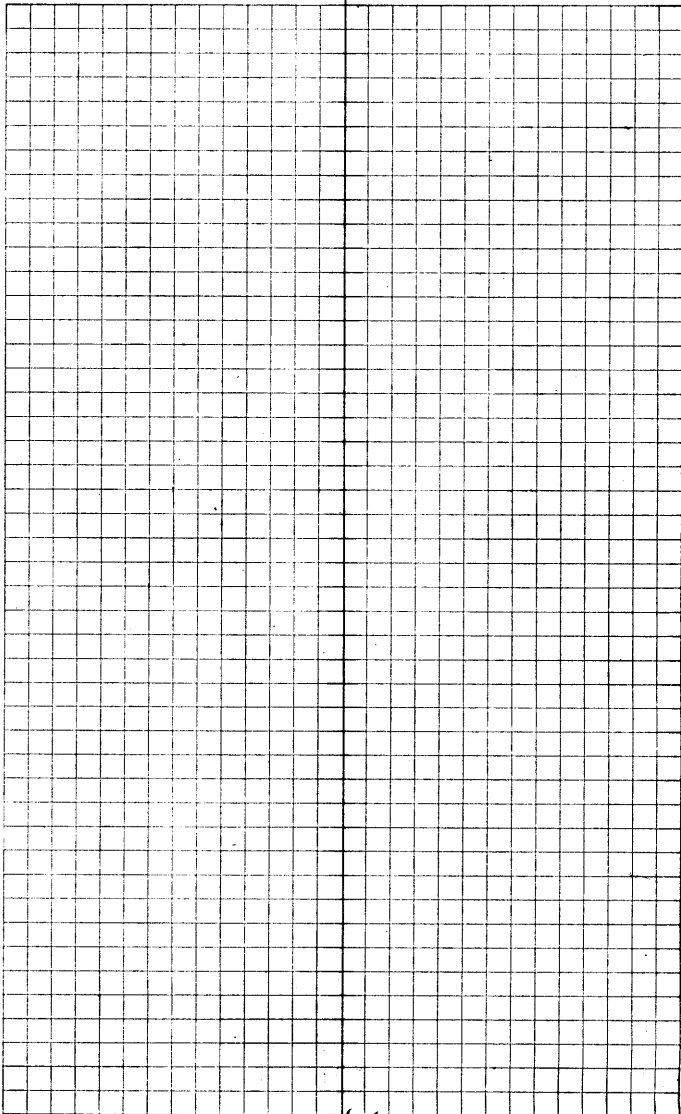

U. S. File No. 34/34