

R 5 W					R 4 W						
6	5	4	3	2	1	6	5	4	3	2	
7	8	9	10	11	12	7	8	9	10	11	12
13	14	15	16	17	18	13	14	15	16	17	18
19	20	21	22	23	24	19	20	21	22	23	24
25	26	27	28	29	30	25	26	27	28	29	30
31	32	33	34	35	36	31	32	33	34	35	36

COUNTY SURVEYOR'S OFS. ROSEBURG, ORE.
CITY OF SUTHERLIN APPLICATION DATA
 For additional Water from Calapooya Cr., Sec. 10, T. 25S; R. 4W.
 SHOWING CONCRETE DAM & DIVERSION NOW IN USE.
 AUG. 1941 - L. Boyer Dep. Co. Survr. - Scales 1"=40' & 200'

85-20


T255
R4W

NECOR 49


12" Fir N40°W 39.

12" W. Oak N66°E 58.5'

{ S48°W 65' AB
18" W.O. Gate Post Aug 15-41
Ed Lewis

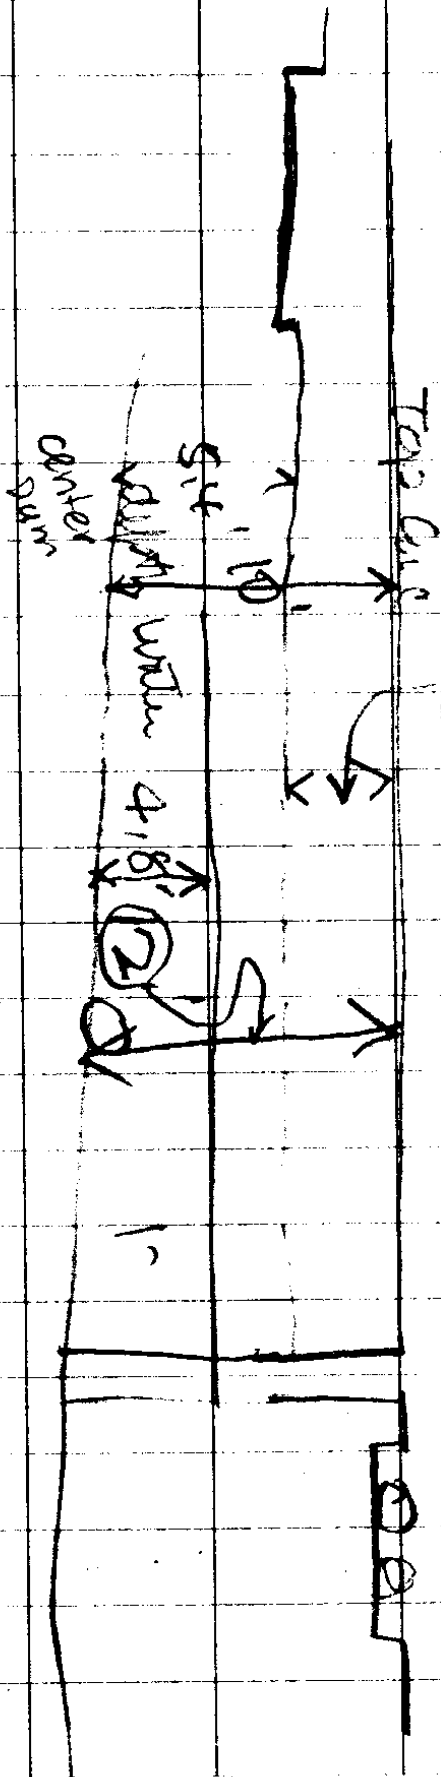

1.5"
 1"

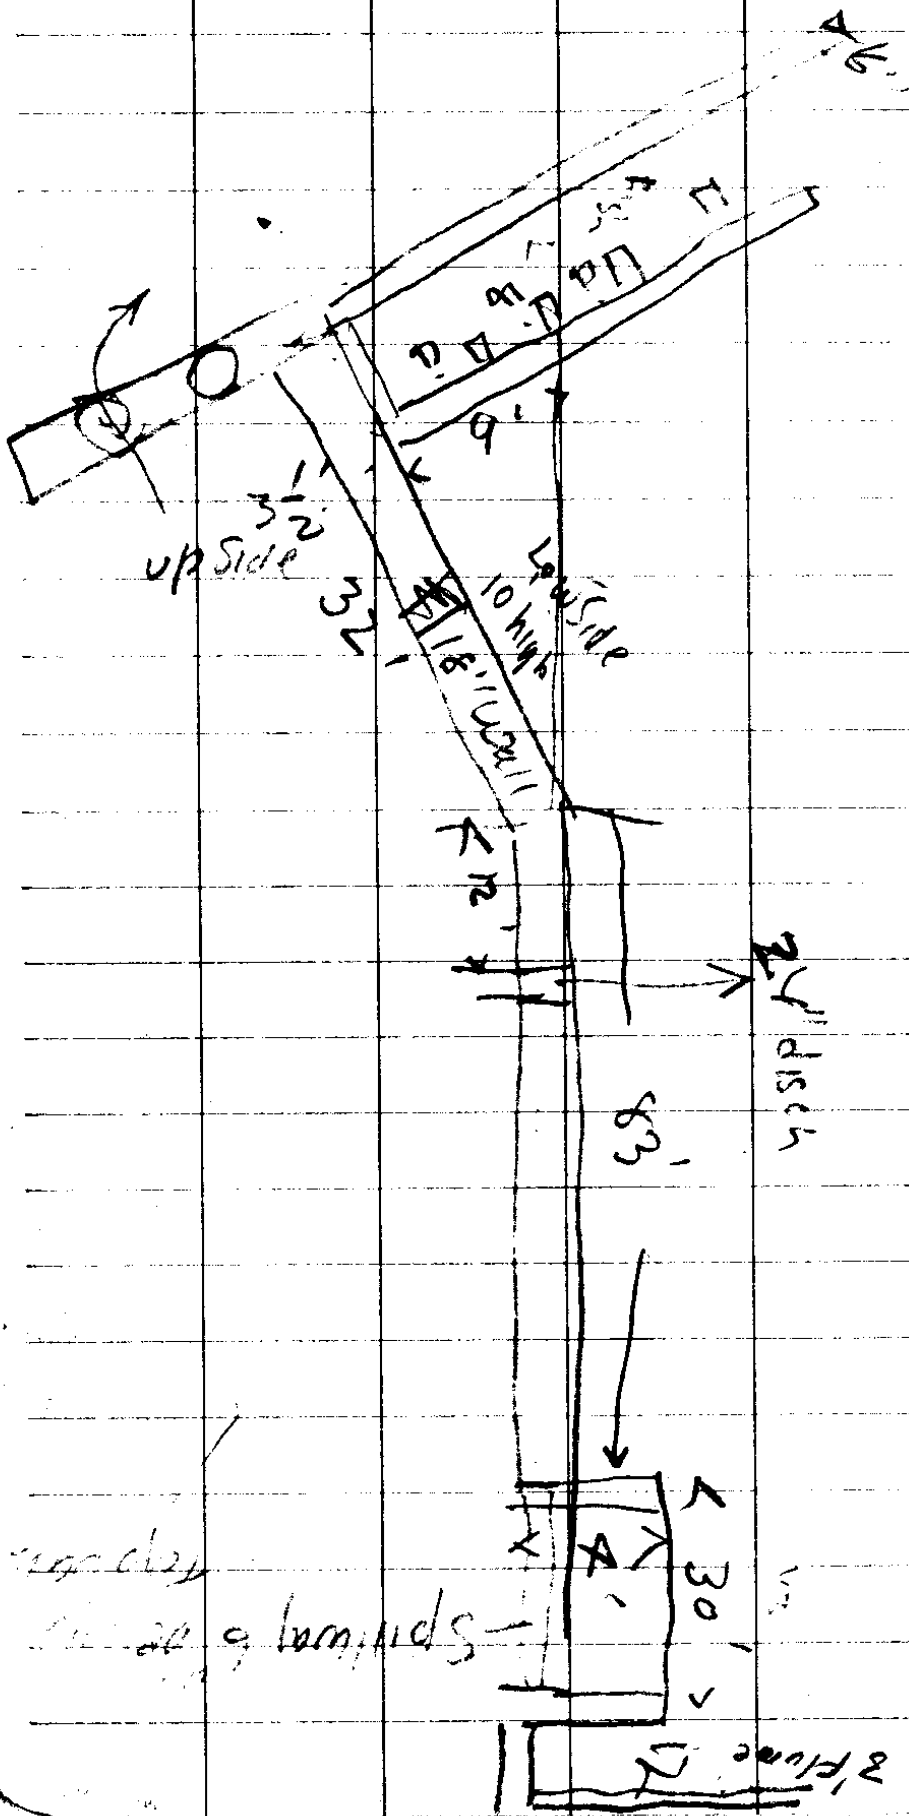

CS FILE FOLDER

CONTAINS

MORE

INFORMATION