


35-35

N.E. Richardson  
Bill Crear


Oct. 24 - 1941



35-35

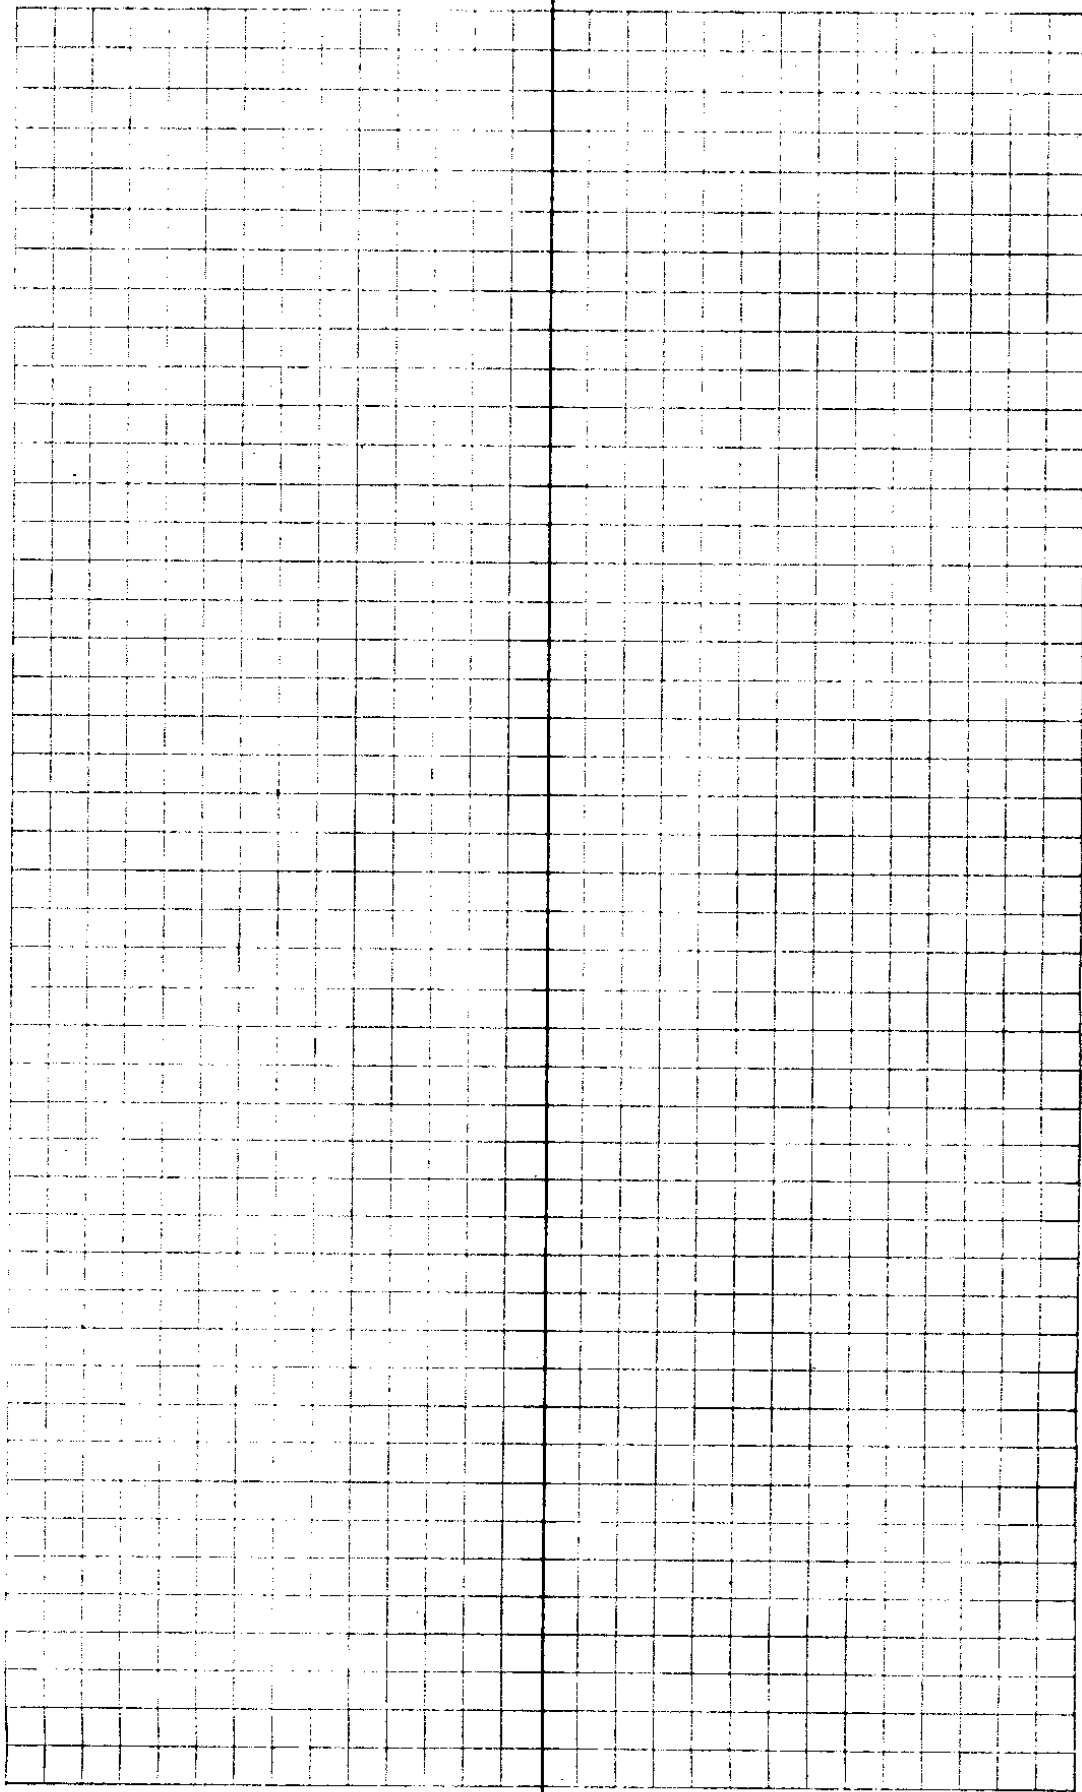

# Seventh-day Adventist

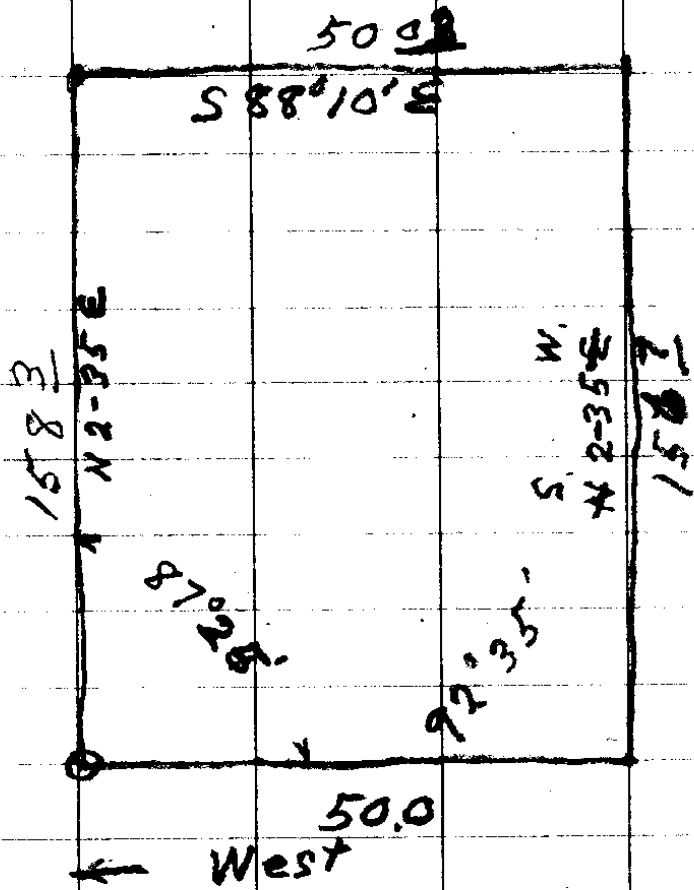

Military Ave.

CS FILE FOLDER

CONTAINS

MORE

INFORMATION