


S. File No. 35-55

Found Street Monument

LOTS 11 & 12 B128
LOTS 2 & 10 INCL B141

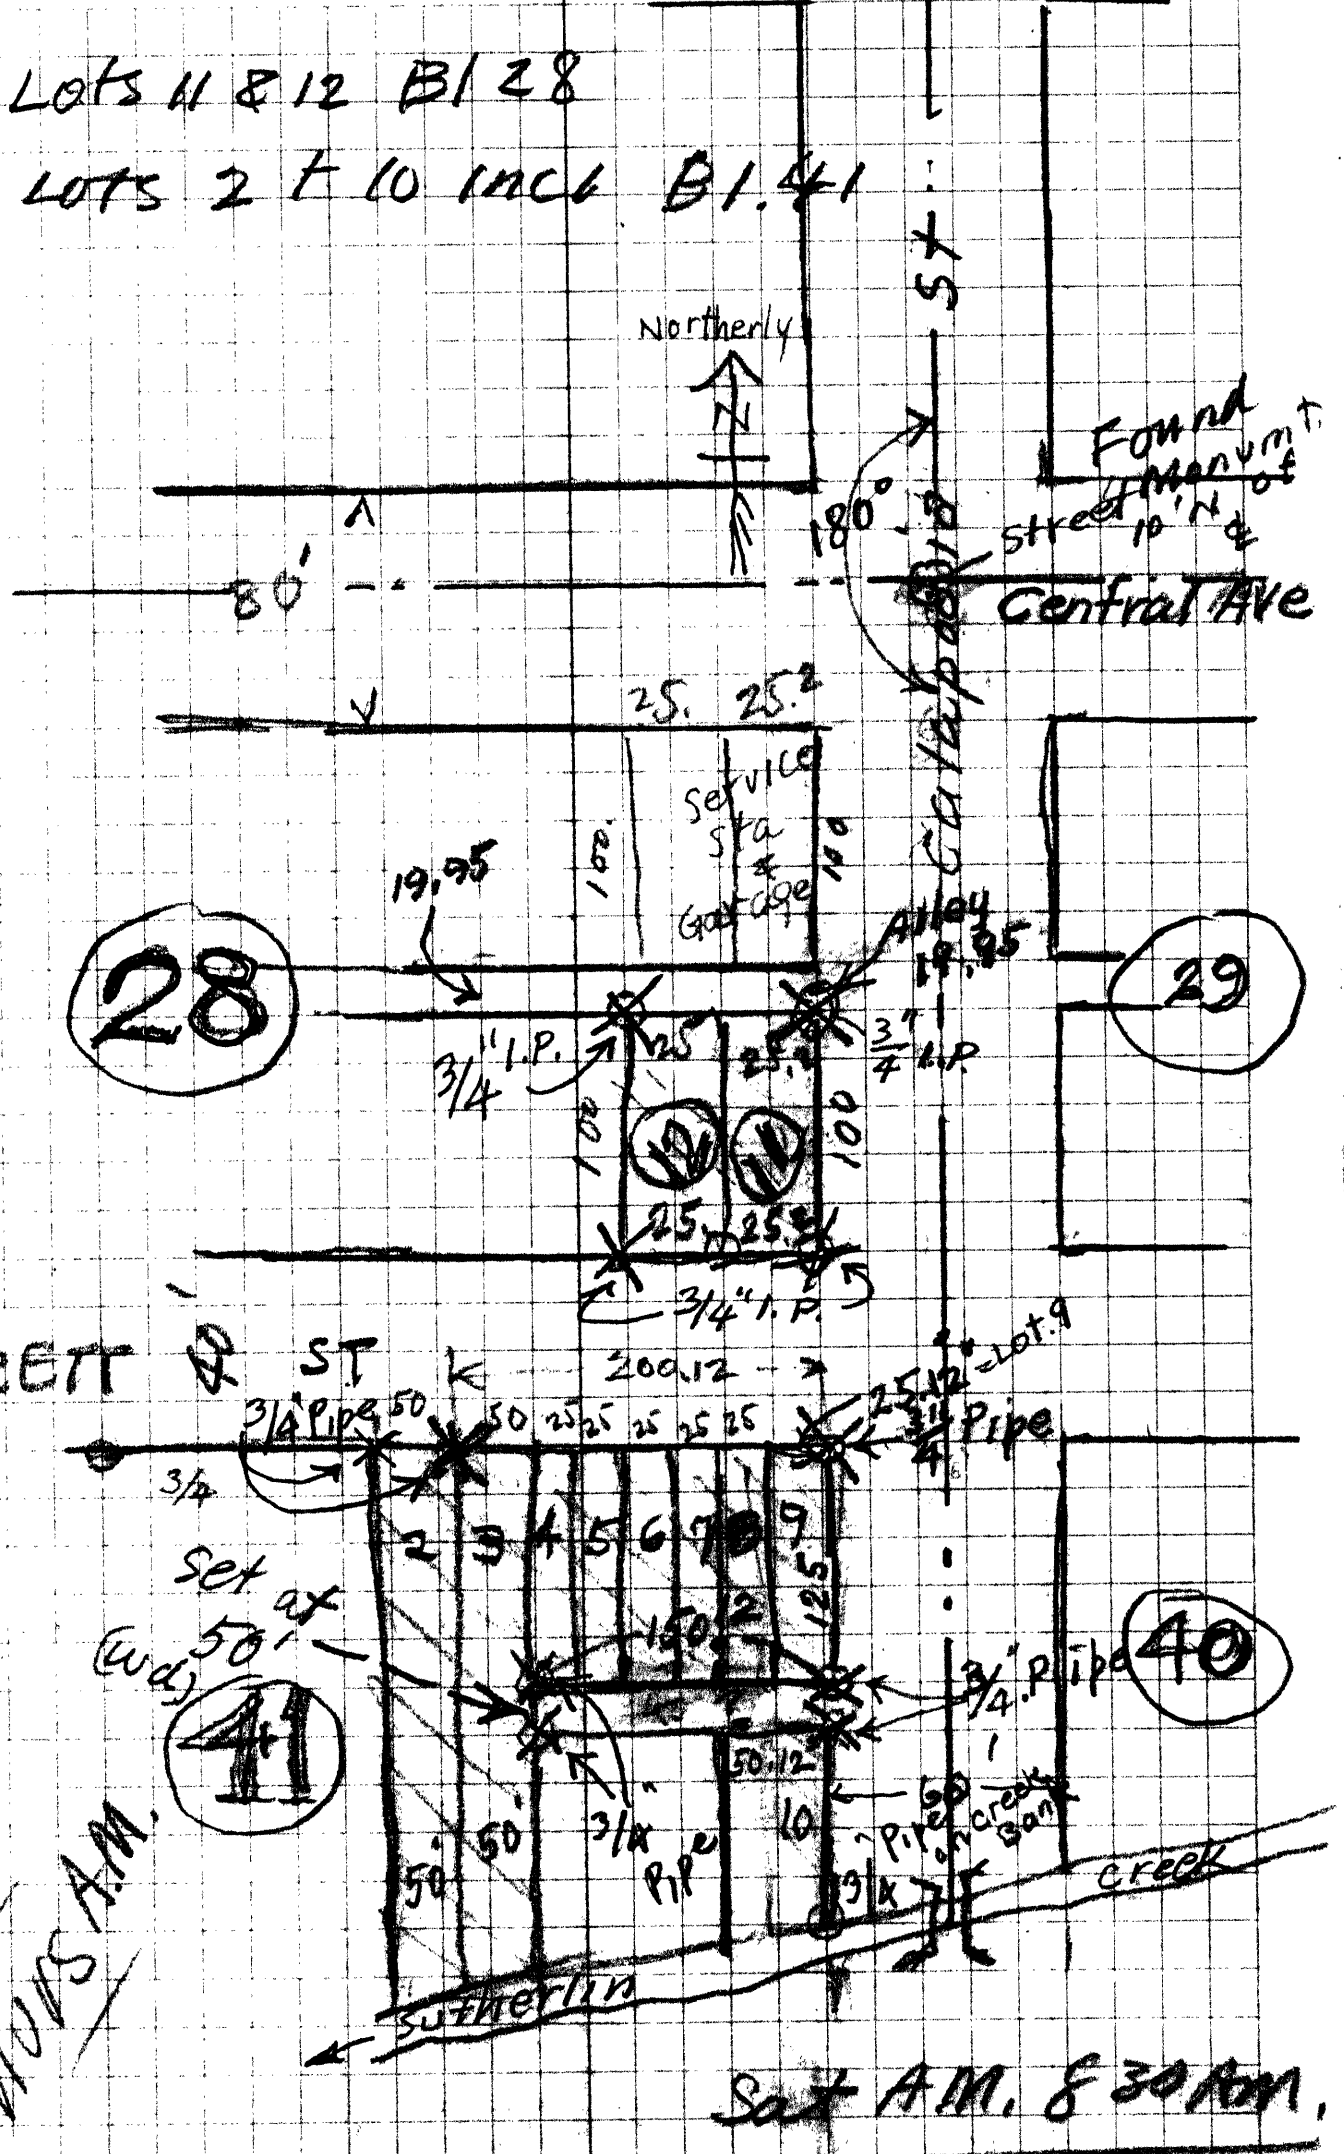

THURS A.M.

Sat A.M. 8:30 AM.

Jan 1-1942
Boyer
Creek Freezing -

Phone Fri P.M. at Wilnots
Dec 26.