


$E\frac{1}{2}E\frac{1}{2}W\frac{1}{2}S\frac{1}{2}4$  :  $E\frac{1}{2}SE\frac{1}{2}$

$\frac{1650}{20.0}$

$\frac{1320}{330}$   
 $\frac{1650}{1650}$

100 A

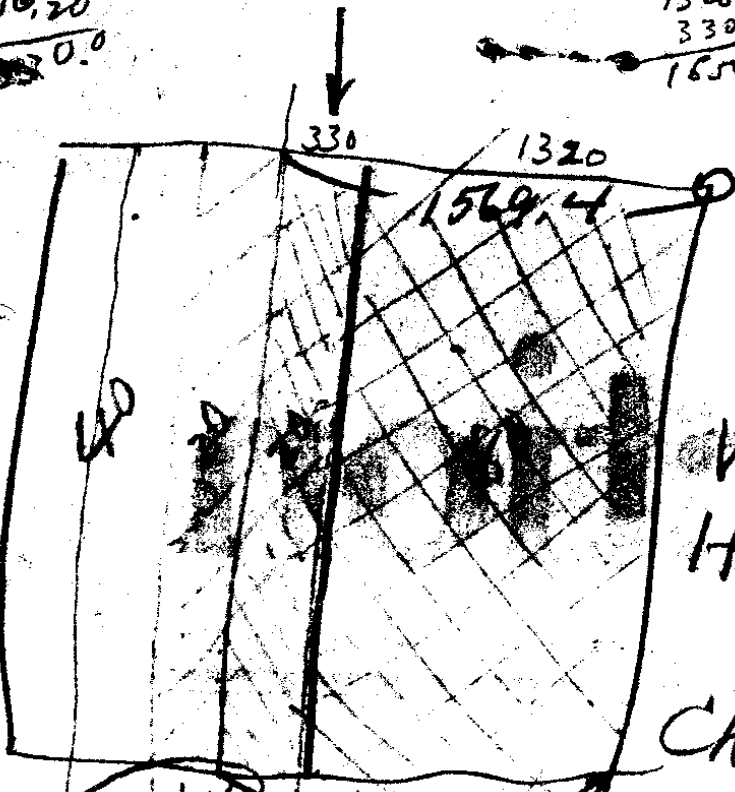

~~44~~  
331

$\frac{1320}{330}$   
 $\frac{1650}{1650}$   
811

Wre  
H. J. Wilkins  
Roseburg to  
Chas<sup>R</sup> Leihy

E. G. Leihy  
Portland

R. Leihy Bayfield Wis

$E\frac{1}{2}S\frac{1}{2}4$  + a strip 20 rods  
wa off 2 side  $W\frac{1}{2}S\frac{1}{2}4$   
Sec 16 -  $\frac{24}{3}$

36/16

Being 100 Acres of the East  
side of SE 4 Sec 16

**DEED OF**

# **Election**

election to be held in

on Friday, the 18th day of May, 1934, there  
State of Oregon for their approval or rejection,  
res as have been referred by the Legislative  
red by petition of the people, and as proposed

**THE LEGISLATIVE ASSEMBLY**

**CONSTITUTIONAL AMENDMENT — Purpose: Requiring  
ness exceeding \$5,000 for roads; authorizing coun-  
law and which they are powerless to prevent: auth-**

Sec 16  
100 AC.

East 100 AC of SE<sup>4</sup> Sec 16  
T24S R3W

Bonham.

Feb-19-42

11

S 88° W 67.5

10 Δ 2° L

N 82° W 58.8 = 58.2

9 Δ 16° R

S 82° W [58.8] = 58.2

8 in Marsh Δ 8° L

119.0 .990

7

132.2 21° 123.3

.933

6

46.6

5

131.5 11° 129.0

.981

4

162.6 F

3

155.9 7° 154.6

.992

2

W 155.5 F

1

109.9 8° = 108.8

.990

2.2 S

W 58.3

1/4 W bet Secs 15 & 16

T 24 S R 3 W

$$\begin{array}{r} 1320 \\ 330 \\ \hline 1650 \end{array}$$

$$\begin{array}{r} 588 \\ 990 \\ \hline 157920 \\ 5292 \\ \hline 582120 \end{array}$$

5280

$$\begin{array}{r} 1099 \\ 990 \\ \hline 98910 \\ 9891 \\ \hline 1088010 \end{array}$$

$$\begin{array}{r} 100 \text{ ac} \\ 25 \\ \hline 20 \\ 165 \\ \hline 25 \\ 825 \\ \hline 330 \\ \hline 3125 \end{array}$$

$$\begin{array}{r} 25 \\ 162 \\ \hline 170 \\ 25 \\ \hline 400 \\ 25 \\ \hline 60 \\ \hline 170 \\ \hline 1650 \end{array}$$

$$\begin{array}{r} 1589 \\ 992 \\ \hline 3118 \end{array}$$

80 - 20

$$\begin{array}{r} 14031 \\ 14031 \\ \hline 1546528 \end{array}$$

$$\begin{array}{r} 1320 \\ 330 \end{array}$$

$$\begin{array}{r} 1315 \\ 987 \\ \hline 1315 \end{array}$$

$$\begin{array}{r} 10520 \\ 11835 \\ \hline 1290015 \end{array}$$

$$\begin{array}{r} 13220 \\ 933 \\ \hline 3966 \end{array}$$

$$\begin{array}{r} 3966 \\ 3966 \\ \hline 11298 \\ 1233426 \end{array}$$

$$\begin{array}{r} 119 \\ 99 \\ \hline 1091 \\ 1091 \\ \hline 11181 \end{array}$$

BT for NW 1/4 this tract  
 S67°E 14.5' - 20" Red fir  
 25' E of Bohemia Trail

~~15~~

~~W 100.8~~

14 = 16.57  $\Delta$  1° 15' R

13° 45' - Note 17' E  
 of 14 = Cor

S88° 45' W 174.0

1344  $\Delta$  2° 30' L

S67°E

N88° 45' W 174.0

~~13  $\Delta$  1° 15' R~~

~~West~~

13° 9' 12  $\Delta$  2° L  $\Delta$  1° 15' R

N88° W 67.5

11  $\Delta$  4° R

16 1/2  
1340

1320  
330  
1650

40 | 120  
25  
60  
50

58.3 1  
1088 8  
158.5 7  
104.6 7  
162.6 6  
129. 3  
46.6 7  
122.3  
119. 2  
116.4 3  
67.5  
67.8

971 | 174.0 (179.2  
971  
7690  
6297  
8930  
8739  
1910  
971  
939

1680  
1309  
341

341  
174  
167  
1008  
612

5 | 1309.1  
1309.1  
174  
114.  
1008  
757.9

1309  
174  
1583  
1650  
1583  
167

1650  
1309  
341  
174  
167  
174

341  
174  
1670  
124  
167  
7

1309.1  
174  
1483.1 up to 13

1650  
1483  
167  
174  
167  
7

36/16

11 = 1570.3 = 1.1.8

78.8 F

10 = 1491.5 = 11.2

S 2° 48' W 189.1 (5°)

188.3

9 = 1303.2 = 9.8

S 10° 173.5 F

8 Δ 20° L = 1129.7 = 8.5

S 1° W 173.5 - 7 1/2 171.9

7 Δ 1° R = 956.2 = 7.2 (175.9)

4.0

300.0 170 286.8

~~6 on side Hot 956~~

~~252.5 14 1/2~~

5 = 665.4 = 5.0

93.0 20° 87.4

4 = 578.0 = 4.3

184.1 12° 179.9

3 on stump 978

27.9

2 = 370.2 = 2.8

S 2-48W 207.0 11 1/2 202.8

1 - 167.4 950 - 1.2

S 2° 48' W 169.8 9 30 167.4

NW Co

167.4	
202.8	3
27.9	
179.9	(0)
87.4	2
286.8	6
175.9	4
173.5	7
188.3	2
78.8	5
291.6	
58.4	4
295.5	3 (6)
12.8	2
217.1	2
168.8	5
121.0	4
<sup>10</sup> 10.9	
2733.9	

16 20.5' W of cr = 2733.9 East

121.0

↓

15 = 2610.5 1 = 19.5

168.1

11°

164.8

.981

14 = 2445.7

= 18.3

221.3

11°

217.1

.981

13 = 2228.6

= 16.7

128

F

300

10°

295.5

.985

12 = 1920.3

= 14.4

58.4


F

300

13½°

972 = 291.6

11

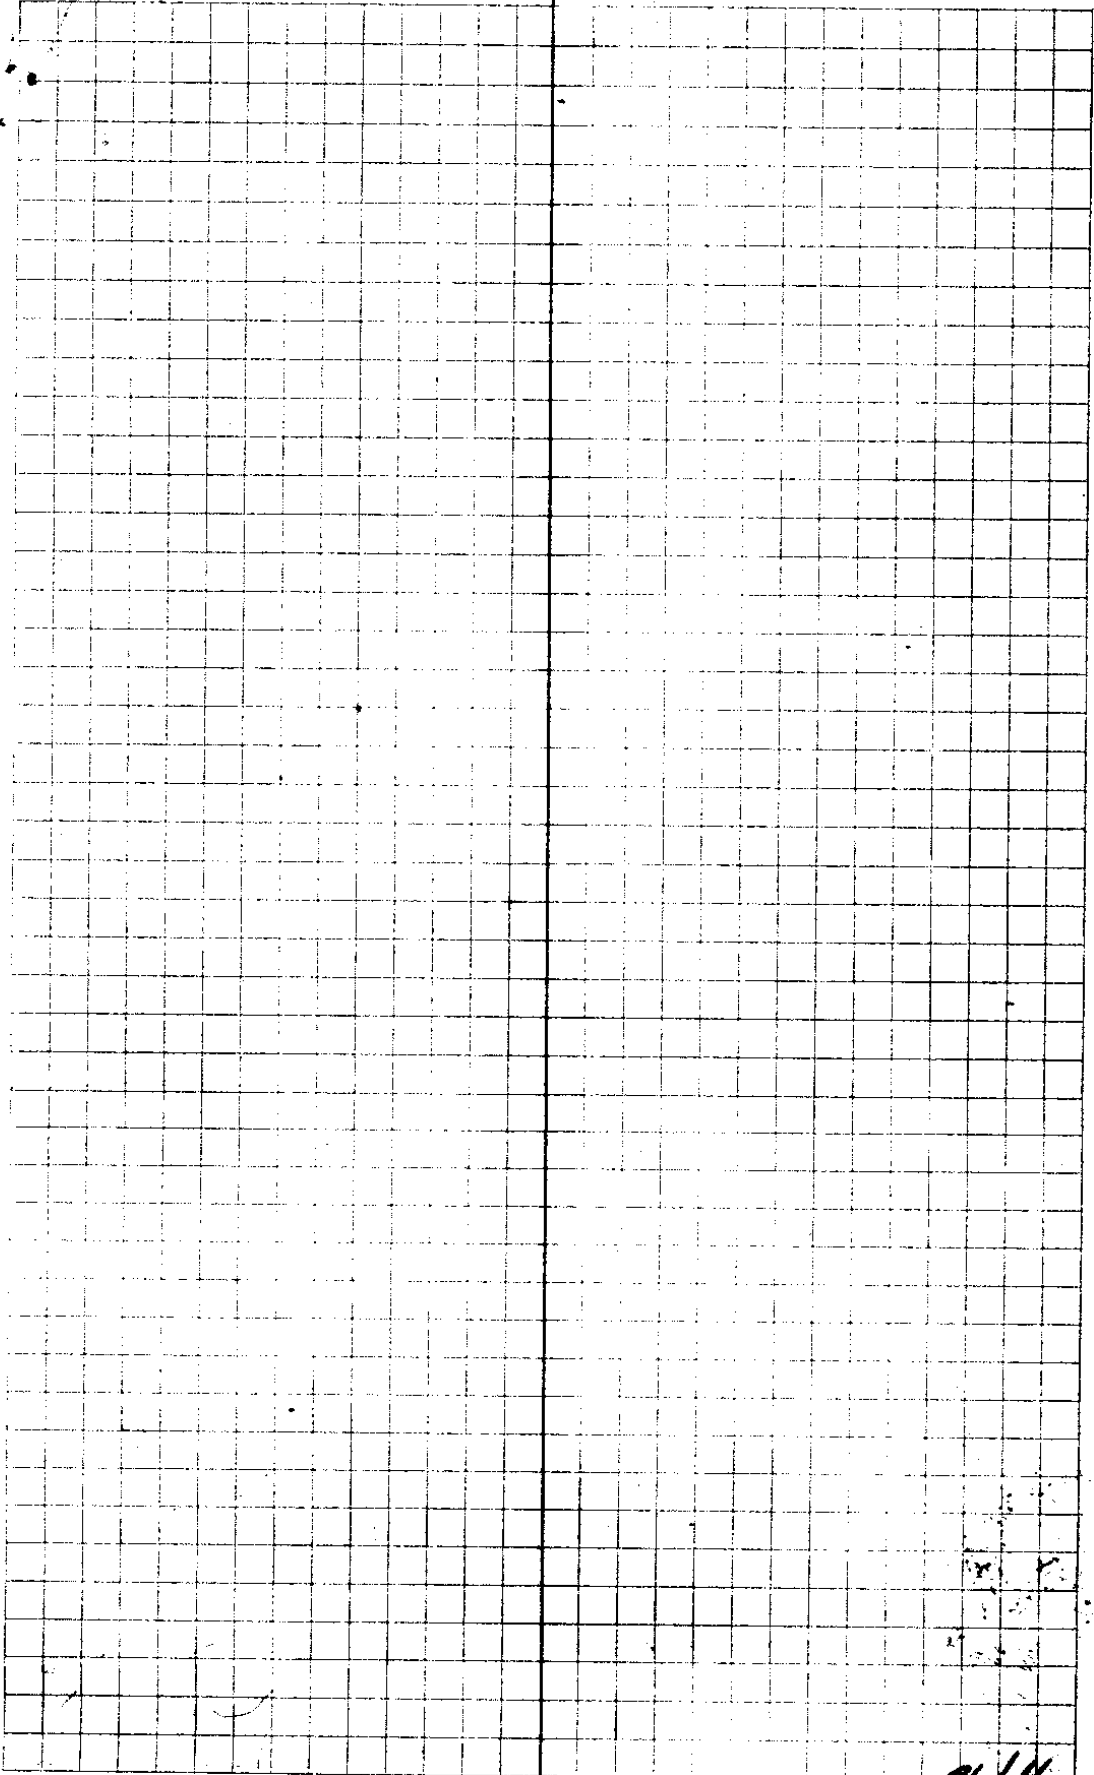

36/16

Leiney Property E 100 ac SE 1/4 16 24/3

11	1650			
	W330			
10	1320			
	V1-82.0			
9	1238.3'			1238.3
	W 212.0° F			41.2
	W 300 <del>300</del>			72.6
				181
				545
8	726		= 30.5'	68
	W 181.0° F			
7	Δ = 10 L = 545.0			
	N89°E 77.4 -			
6	Δ 2° R			545
	S89°W 77.4			154.8
				390.2
5	Δ 1° Left = 390.2			744
	S85°W 37.4	37.2		315.8
4	Δ 10° L			
	N85°W 37.4	F = 37.2		
3	Δ 5° R			315.8
	W 214.0 F			214
2				102.0
		66.5	F	
1				
		36.6	13-20' = 55.6	
			.973	

CR  
2016

Thursday Jan 28 '2

973 366 5838 5838 2919 <u>3561</u> 18	356 5 665 8 2140 7 744 6 154.8 181. 1 512 8 <u>1238.3</u>	796 374 3484 6972 2988 <u>3725</u> 04	1659 1238 <u>421</u>
--	--	--	----------------------------

1320  
1238  
82

330

04204  
04204  
1238 (5)  
33632  
12612  
8408  
4204  
5204552

4222  
555  
372  
744  
214  
665  
356  
316.1  
356  
665  
102.1

04204 (6)  
726  
25224  
8408  
29428  
3052104

04204 (1)  
316  
25224  
4204  
12612  
1328464

04204 (3)  
102  
8408  
204  
22880.8

04204 (5)  
545  
21020  
16816  
21020  
2301180

36/16

West on Line Bet 16-21

Var. (19°E)

19.50 Creek 2 Lks wide

40.00 set 1/4 sec post from which.

A 10° fir B N 5° E 40 lks.

" 7 " " S 28° E " "

47.00 To Trail, To Bohemia Mines

58 = Creek Bottom

60.25 = Creek,

80 = cor - 10" Ald. 270 S 52 L

12" " S 10 E - 13 L.

40" " S 50 W 22 L.

6" " N 20 W 31 L.

S 14.75 = Boh. Trail,

CS FILE FOLDER

CONTAINS

MORE

INFORMATION