


Tp. 21 S. R. 5 W.

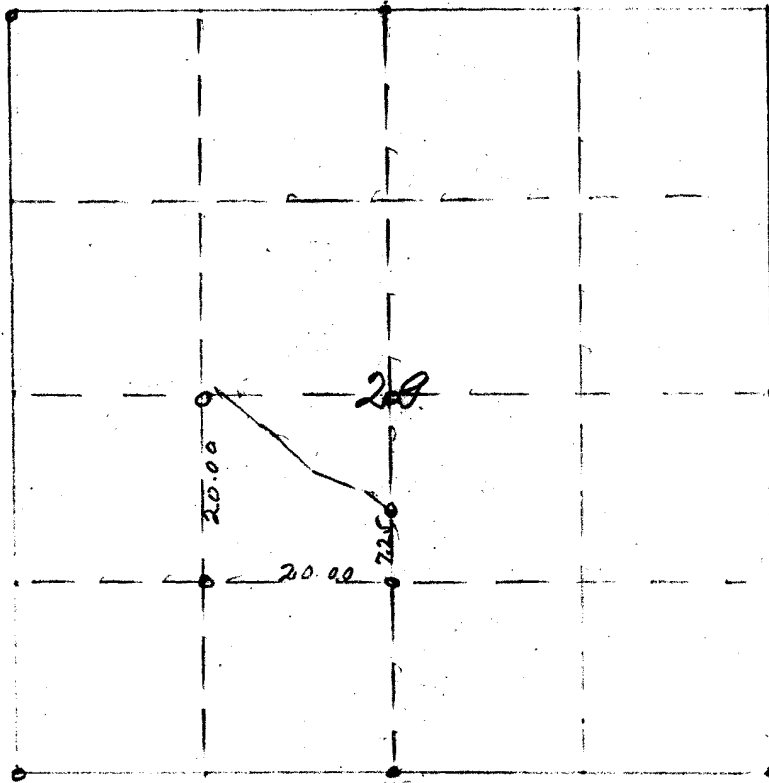

Survey begins 7.25 chains North of the S.E. cor.
of the N.E. 1/4 of S.W. 1/4 of sec. 29. Tp. 21 S. R. 5 W.
thence as follows. to-wit:-

N. 47 1/2 W	2.40 chains
N. 65 W.	5.00 "
N 50 W.	5.20 "
N 39 W.	2.10 "
N 55 W.	5.10 " to line

This does not check O.K with an old corner.
If not satisfactory send back and I will
see where the trouble lies.

O.F.T.

CS FILE FOLDER

CONTAINS

MORE

INFORMATION