


585

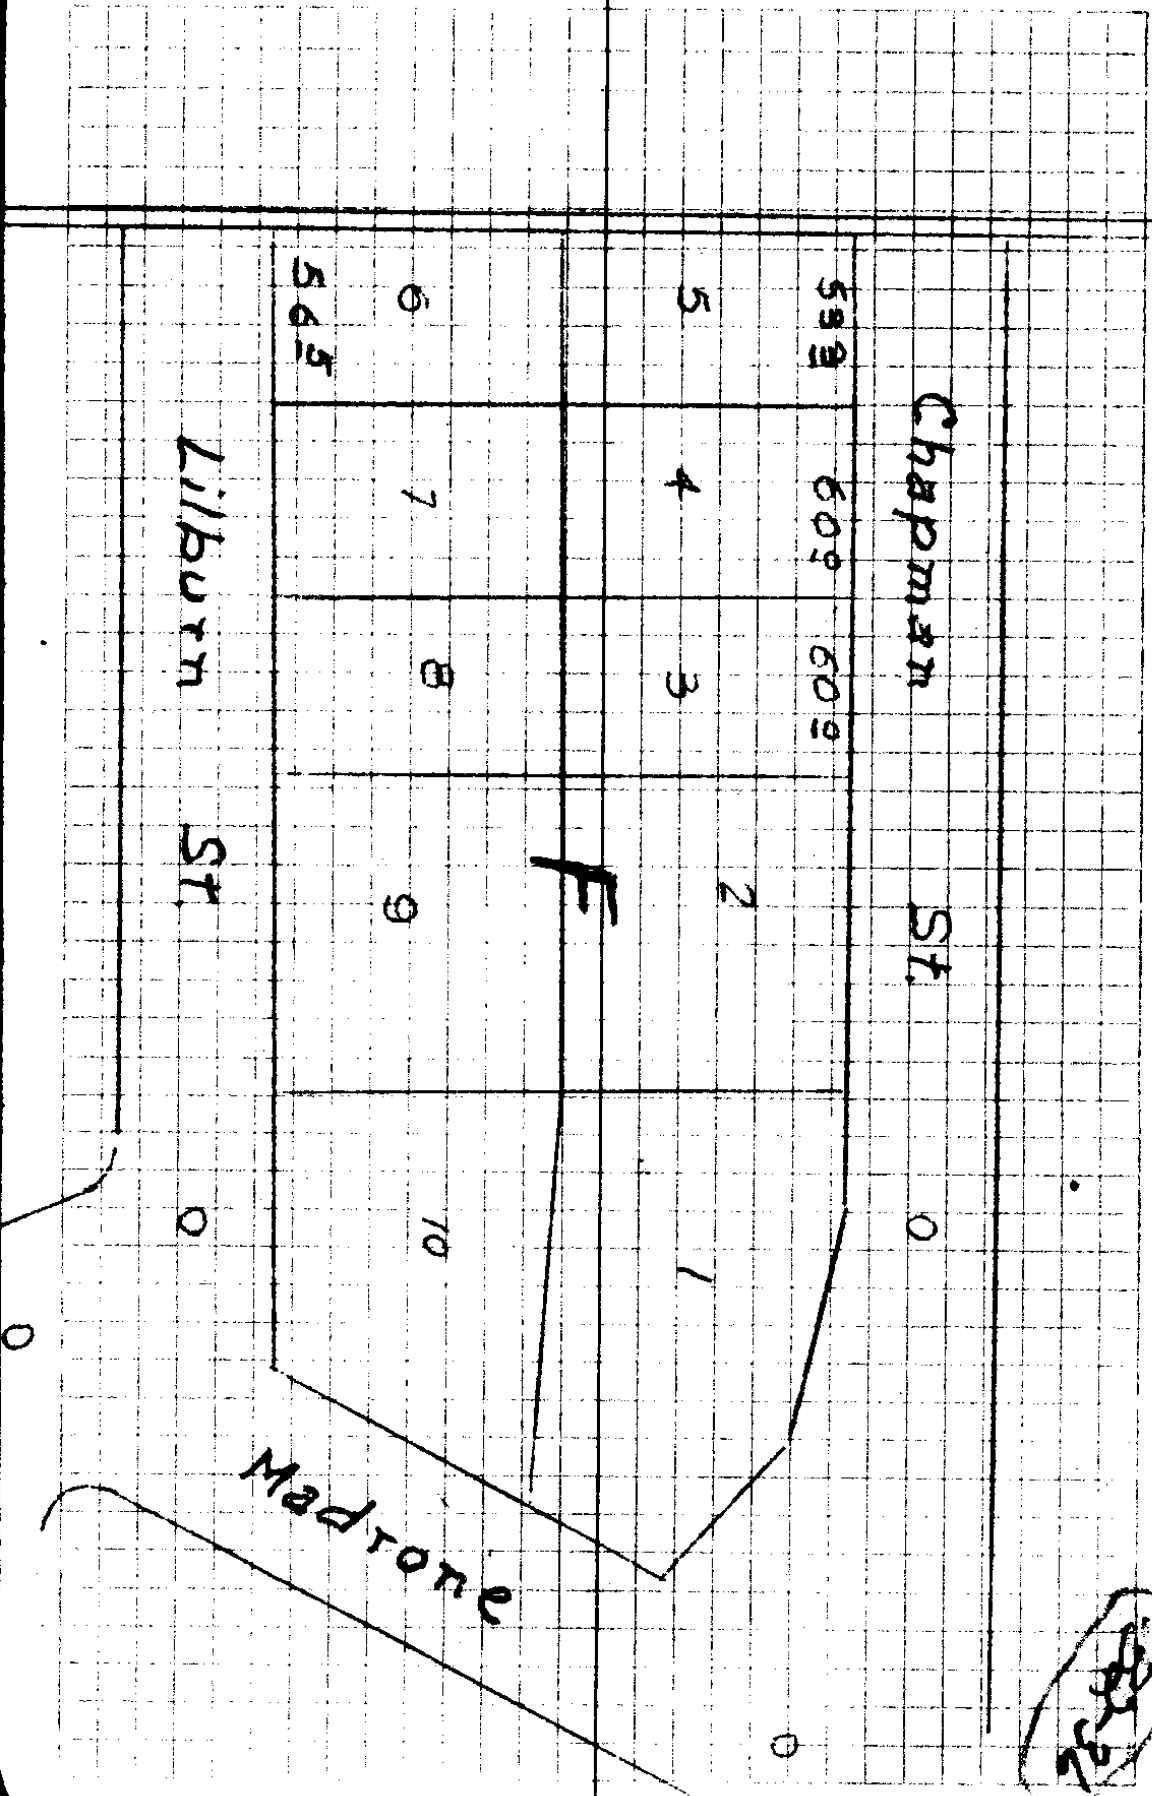

Chapman

St.

Libburn

St.

Madrone

585

600

600

0

0

5

4

3

2

1

6

7

8

9

10

585


0

0

F

Block "E" Lautelwood
N 0° 15' W

570

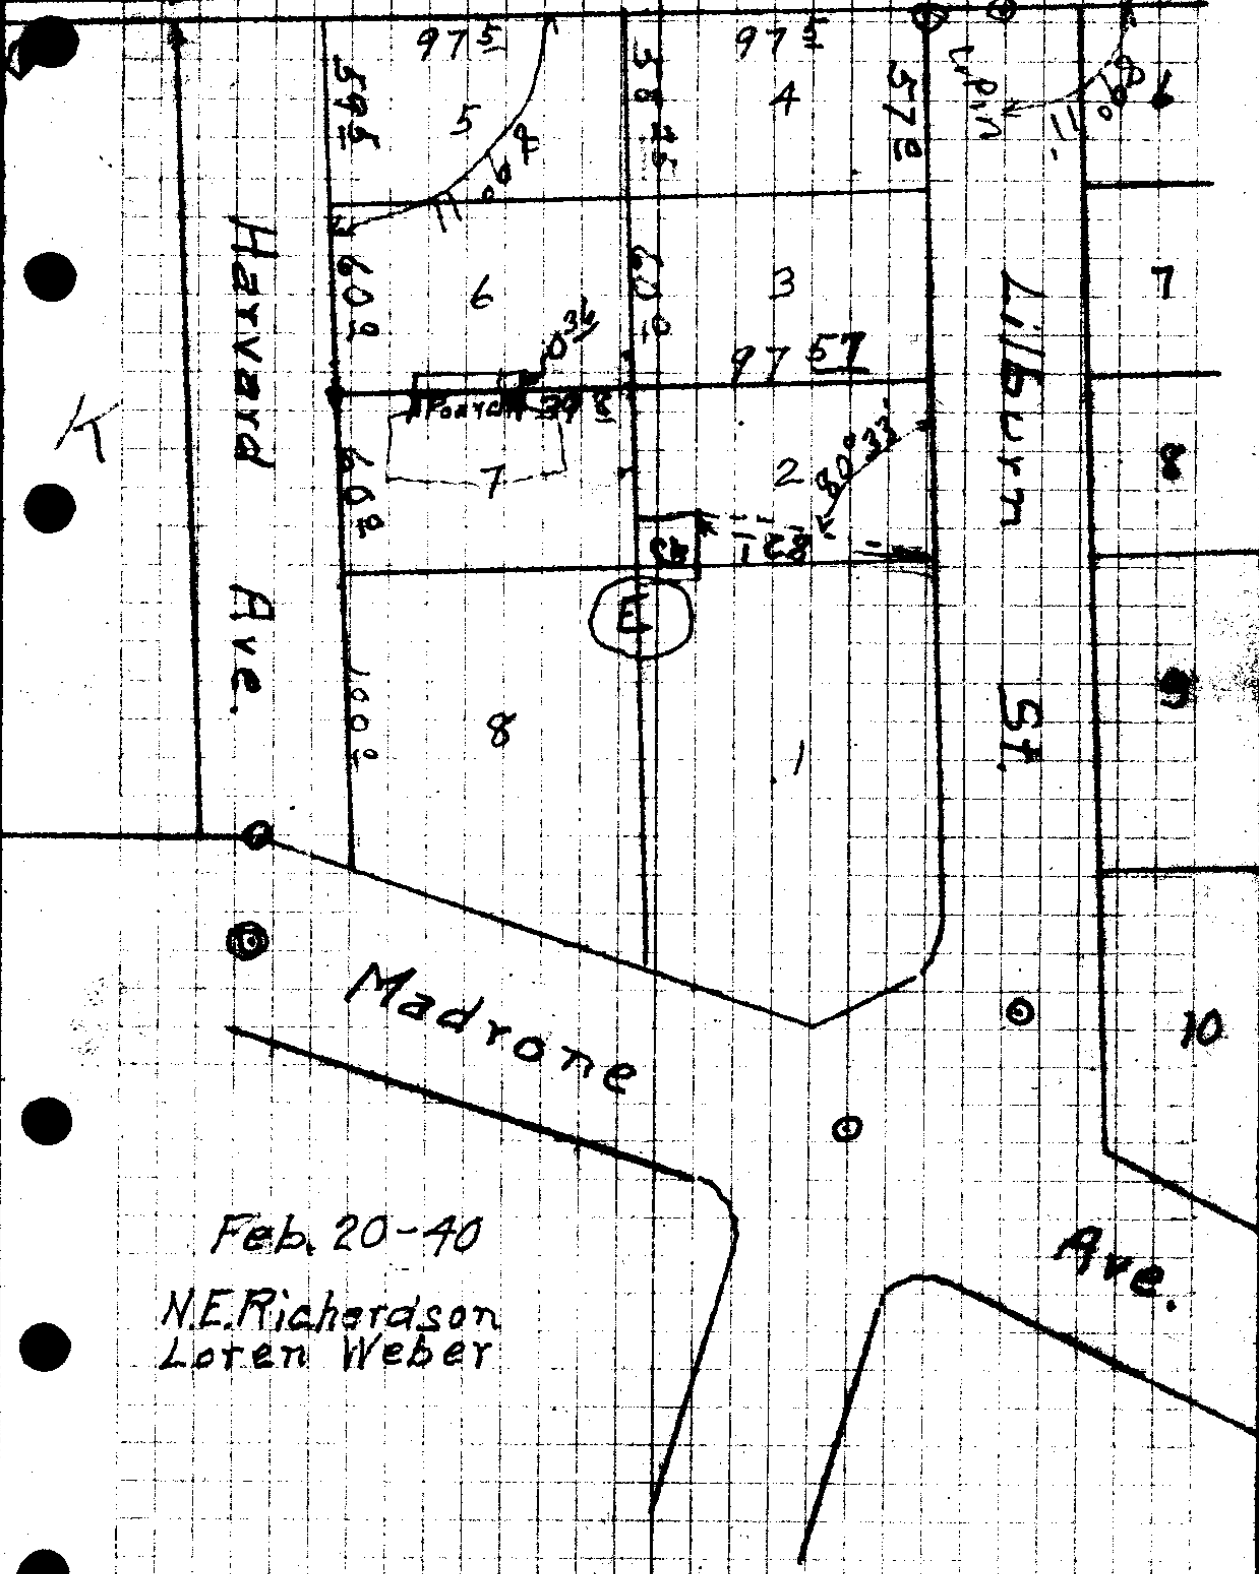

Feb. 20-40


N.E. Richardson
Loren Weber

32 36/20A
V. ~~32~~ - E 36

Dec 7-1939

H. Epstein
NE Richardson
Loren Weber

80
75

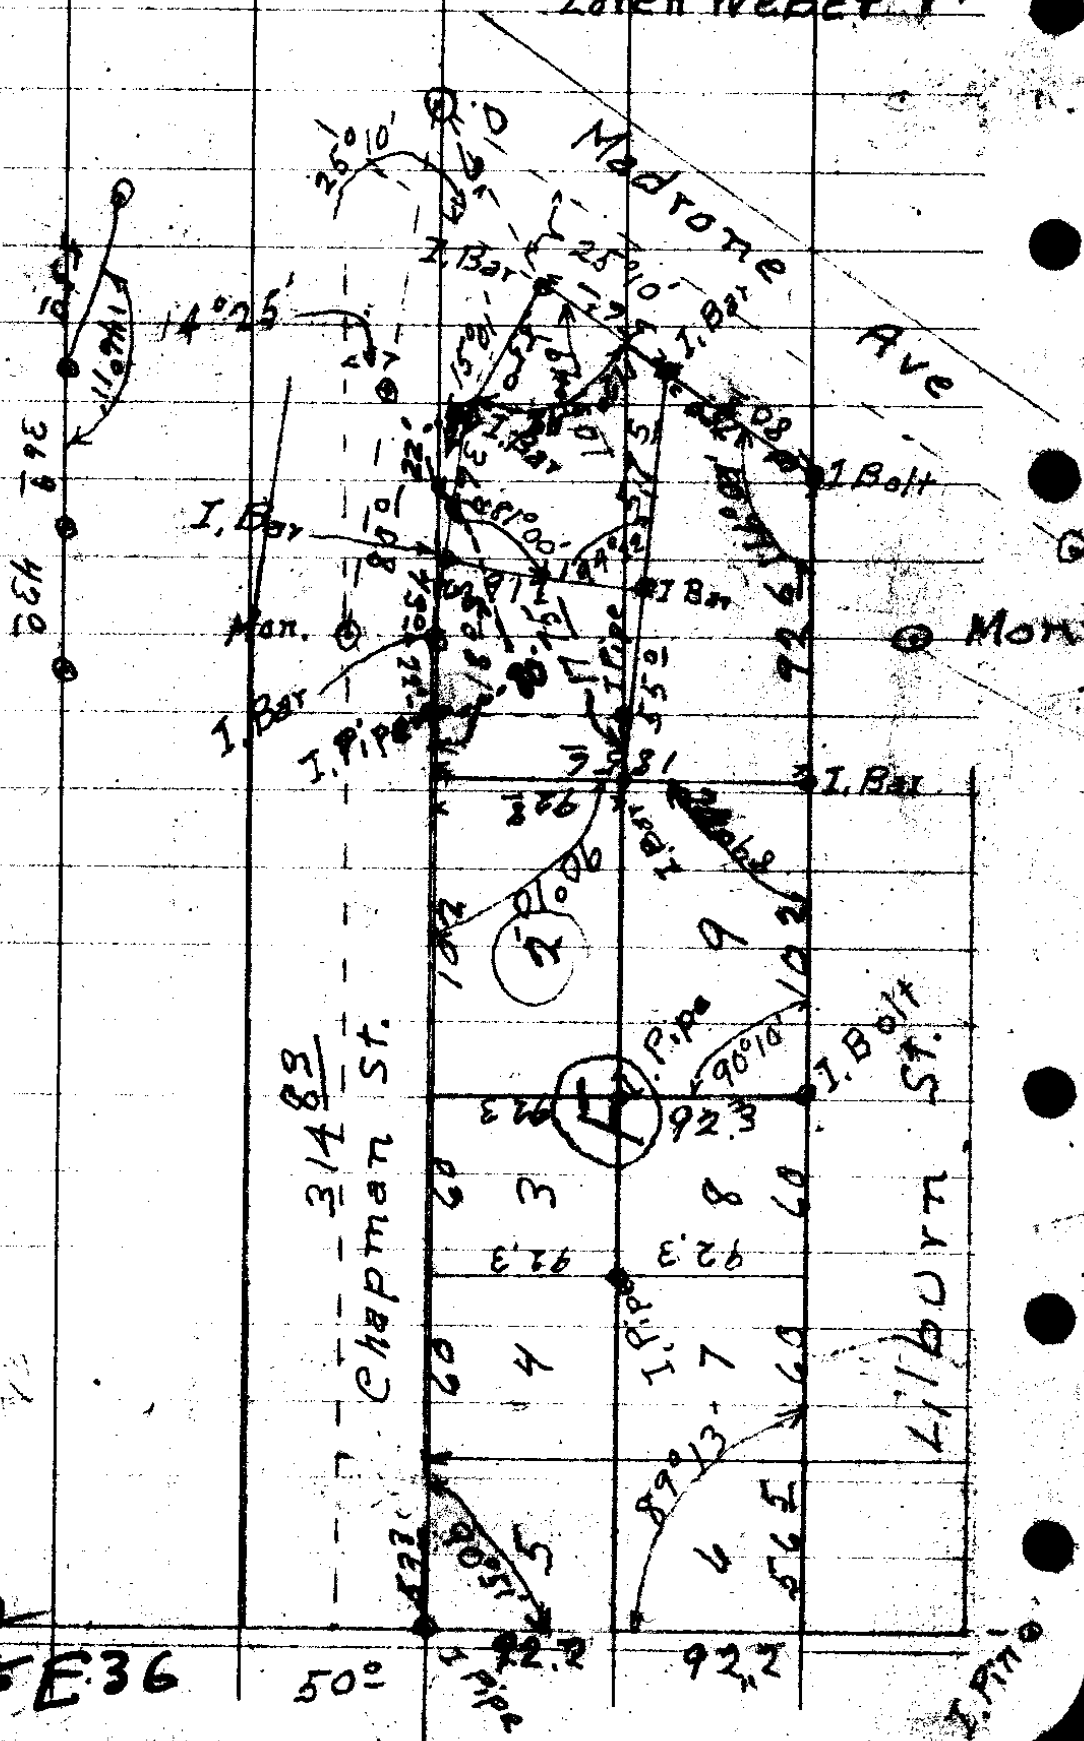

43
76
91
72

32
E 36

50°

I. Pipe