


A N Geades

36-40

3/13/43 Boyer Pipes

Found

383.43'

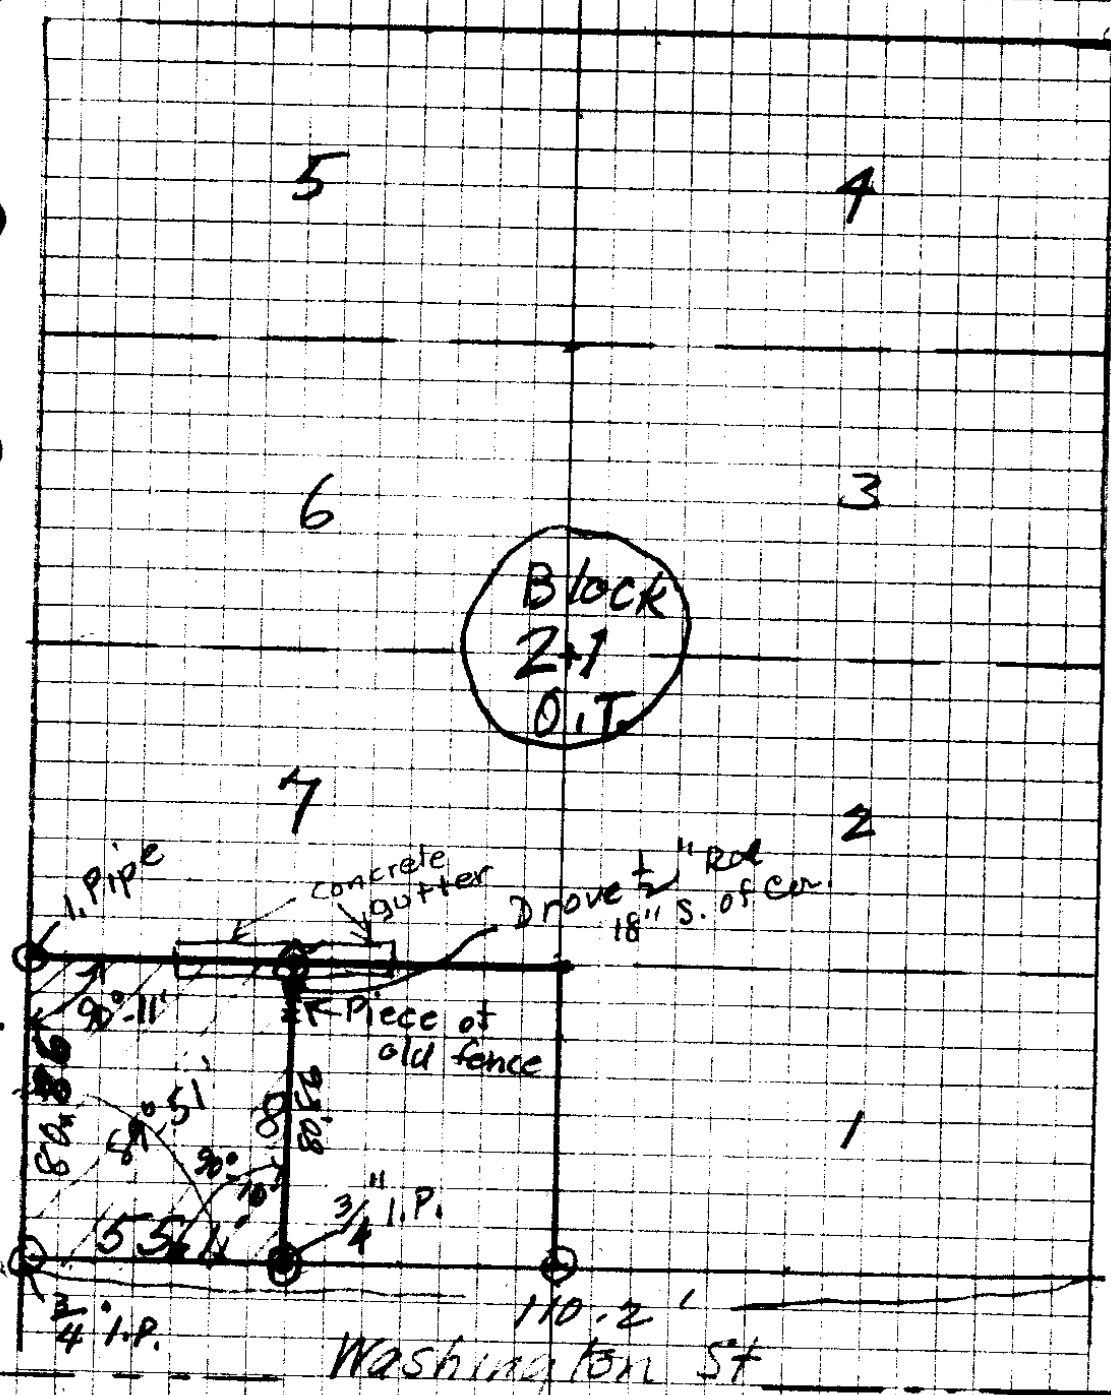

Found

W 1/2 lot 8 B. 21 O.T.

V 36
E 40

P.C.S. 36/40

Found