


Mar. 23, 1943
Boyer-Piper

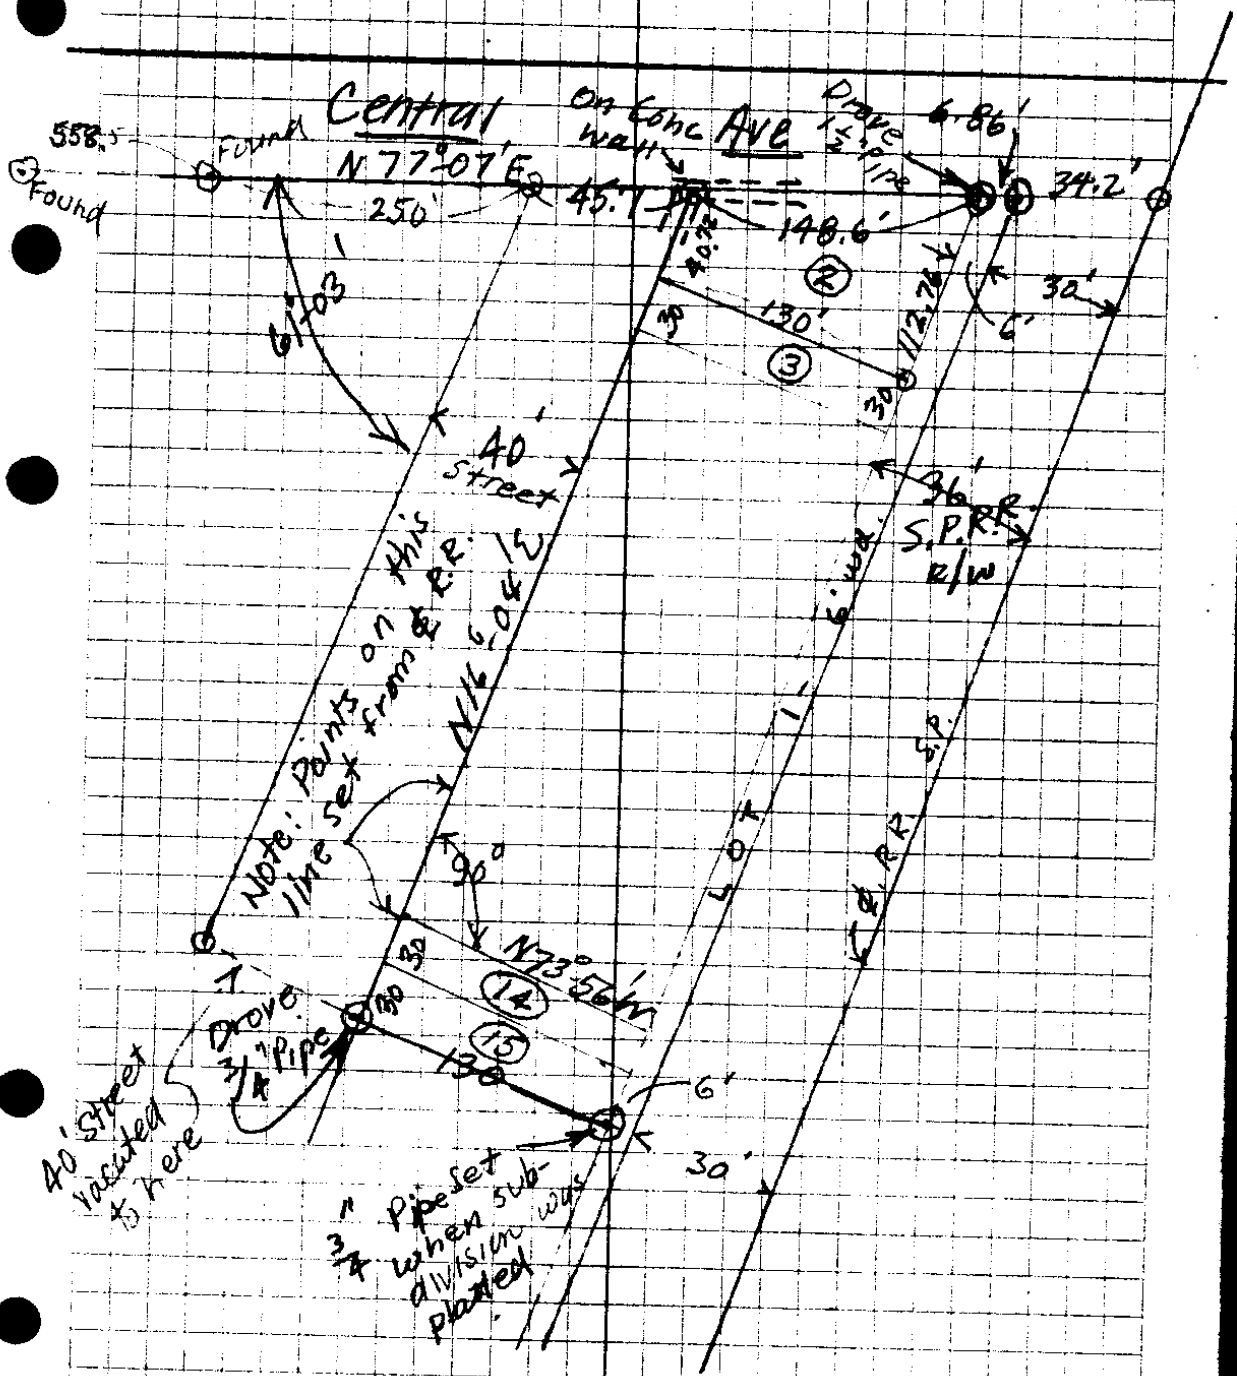

Plat 0 - Improved Block 1
Sutherland & W. Co.