




Aug 42  
Boyer  
Operator  
R. S. ...

Cor 5-6-7-8

18" y. OAK S 18° W 475 L  
 18" " S 37° E 230 L  
 15" " N 57<sup>3</sup>/<sub>4</sub>° E 614 L  
 12" W.O. - S 48<sup>1</sup>/<sub>2</sub>° E 93.5'

stone 18x8x (8" W.O. N 69<sup>1</sup>/<sub>2</sub>° E 202.0)  
 stone 37x8x6

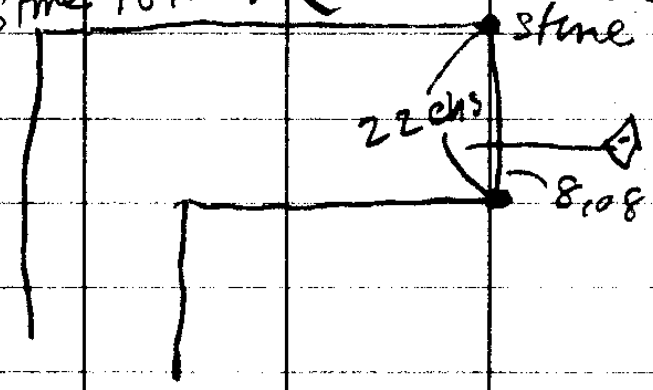

40  
6.5

300  
~~211~~

$\begin{array}{r} 22 \\ 66 \\ \hline 132 \\ 132 \\ \hline 1452 \end{array}$	$\begin{array}{r} 65 \\ 66 \\ \hline 390 \\ 390 \\ \hline 4290 \end{array}$	$\begin{array}{r} 230 \\ 66 \\ \hline 1380 \\ 1380 \\ \hline 15180 \end{array}$	$\begin{array}{r} 475 \\ 66 \\ \hline 2850 \\ 2850 \\ \hline 31350 \end{array}$	$\left. \begin{array}{r} 313 \\ 224 \\ \hline 89 \end{array} \right\}$
$\begin{array}{r} 614 \\ 66 \\ \hline 3684 \\ 3684 \\ \hline 40524 \end{array}$	$\begin{array}{r} 960 \\ 429 \\ \hline 531 \end{array}$	$\begin{array}{r} 300 \\ 89 \\ \hline 211 \end{array}$	$\begin{array}{r} 300 \\ 89 \\ \hline 211 \end{array}$	
$\begin{array}{r} 300 \\ 2005 \\ \hline 935 \end{array}$				
$\begin{array}{r} .989 \\ 252 \\ \hline 978 \\ 4645 \\ \hline 1978 \\ 249228 \end{array}$				

36/48



CS FILE FOLDER

CONTAINS

MORE

INFORMATION