

School District 52

Hans Weaver Clerk

Aug 21 1929.

B B Irving

T

H C Baird

H C.

NE Cor Pipe

20

N 30° 19' E N 30 1/2° E

SE Cor

30° 11' R

5367

N 0° 8' E

N

-0° 54'

2367  
300°

C

2 1/2  
1° 32' L

21987

N 1° 40' E

A

Hub,

2758

N 37° E

N 37° E

2  
+ 1/2  
6° 33' 276


SW Cor Cl 48

Var 21° E

2195

1875

290  
771  
79  
150.1

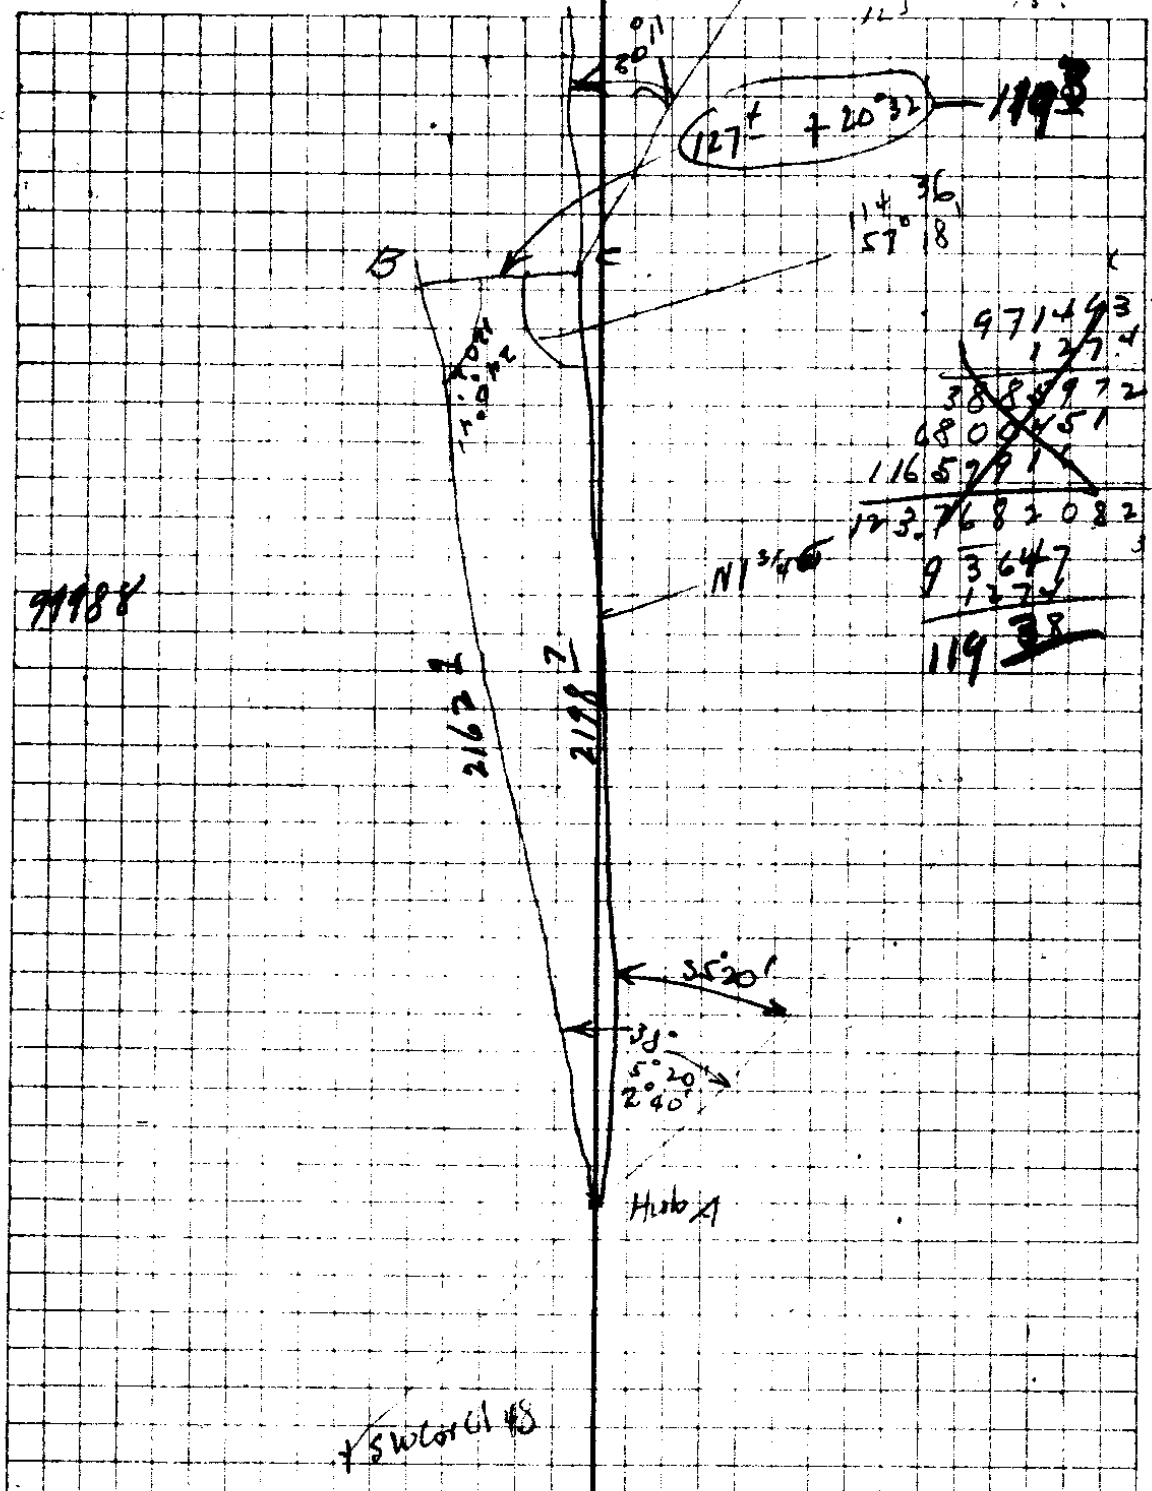

99988

971.493  
~~127.4~~  
~~388.972~~  
~~480.451~~  
~~116.5791~~  
 173.7682082  
 93.647  
 127.4  
 119.38

99347

Cedar Post Mk'd  $CL48$   $C_2$  - Orig BT WD N20° E  
 452lbs Figured rotted tree hollow. BT not checked  
 and  
 Set Sand stone  $6 \times 8' 16''$  long  $\times$  on top  
 48 on N & face  
 144' Fir  $5 12''$  w. 359 ft sciled  $CL49$   $CL51$   
 80 N29° W 103° + 11" C. S. EN. HO. DT. 371

Hans Weaver Clerk

Dist #52 - Myrtle Crk

1952