



C.S. FILE 37/1
M17-47

1/2 fence on Property line
supposed to be on true
Section line and used as such
for many years. Bearing
assumed as North $10^{\circ} 30' E$.

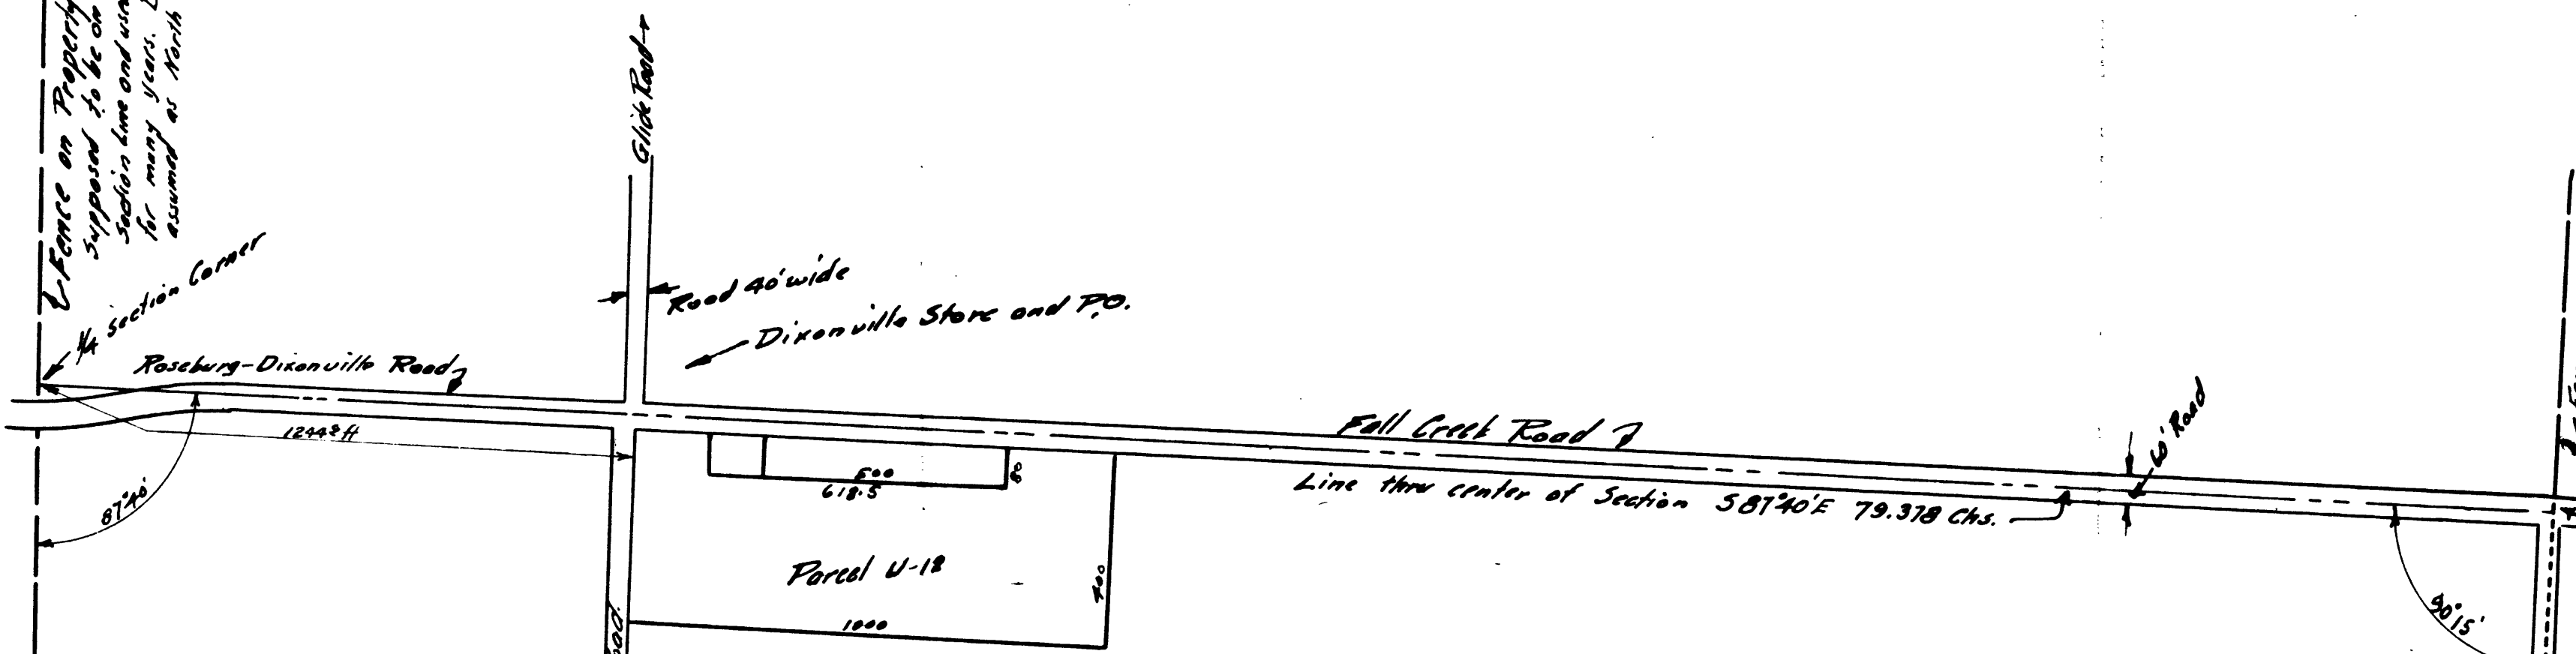

1/4 section corner gone.
Section corner 1/2 mile south
gone but E & W line
is 240 chs South. Sec 24
gone and no property lines
exist to check location.

Sight to township
line 1/4 mile South line
in O.K.

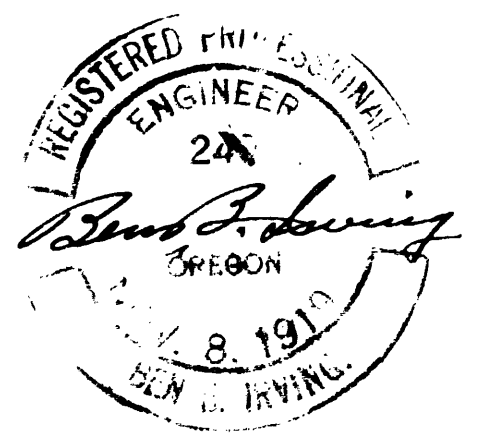

Partial Plat of
SECTION 24 T 275 R 5W
showing
E & W Line thru Center of Section
Surveyed & Plotted by
BEN. B. IRVING ROSEBURG, ORE
Registered Civil Engr. - Deputy County Surveyor
November 4, 1929
Scale 1" = 200'

C.S. FILE 37/1
M17-47