


T 305 RAW

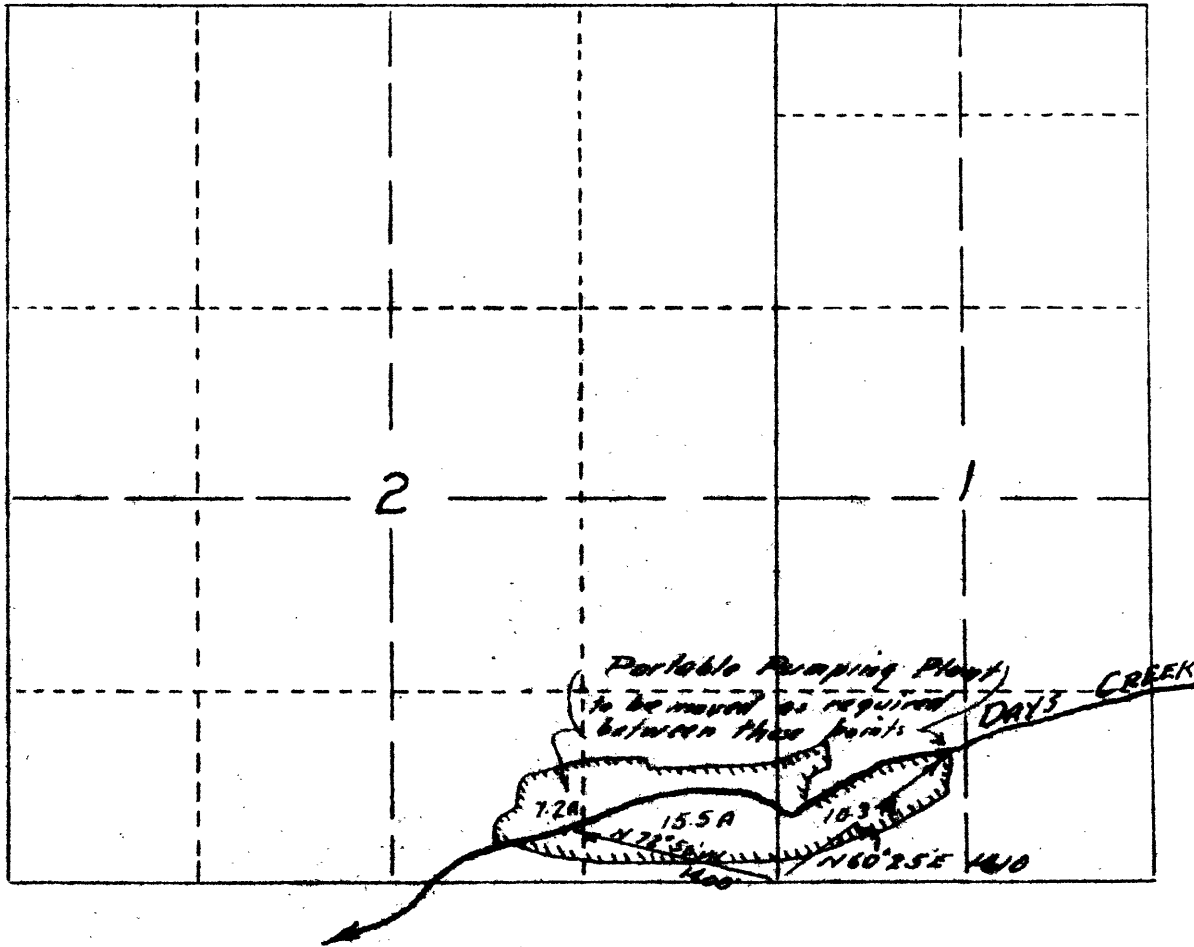

IRRIGATION SYSTEM
OF
H. WOLLEMBERG ESTATE
SECTIONS 182 T 305, R 4W WM.

I, BEN. B. IRVING, of ROSEBURG, OREGON, do hereby certify that this map was made from notes taken during an actual survey made by me on NOVEMBER 19, 1934 and that it correctly represents the works described in the accompanying application, together with the location of streams and other ditches in the immediate vicinity

Ben B. Irving
REGISTERED PROFESSIONAL ENGINEER

OREGON No. 240
NOVEMBER 8, 1919