


COUNTY SURVEYORS FILE DATA  
DO NOT REMOVE FROM OFFICE

CALIFORNIA OREGON POWER CO.  
SUBSTATION PROPERTY  
Sutherlin, Oregon.

SCALE 1" = 100'

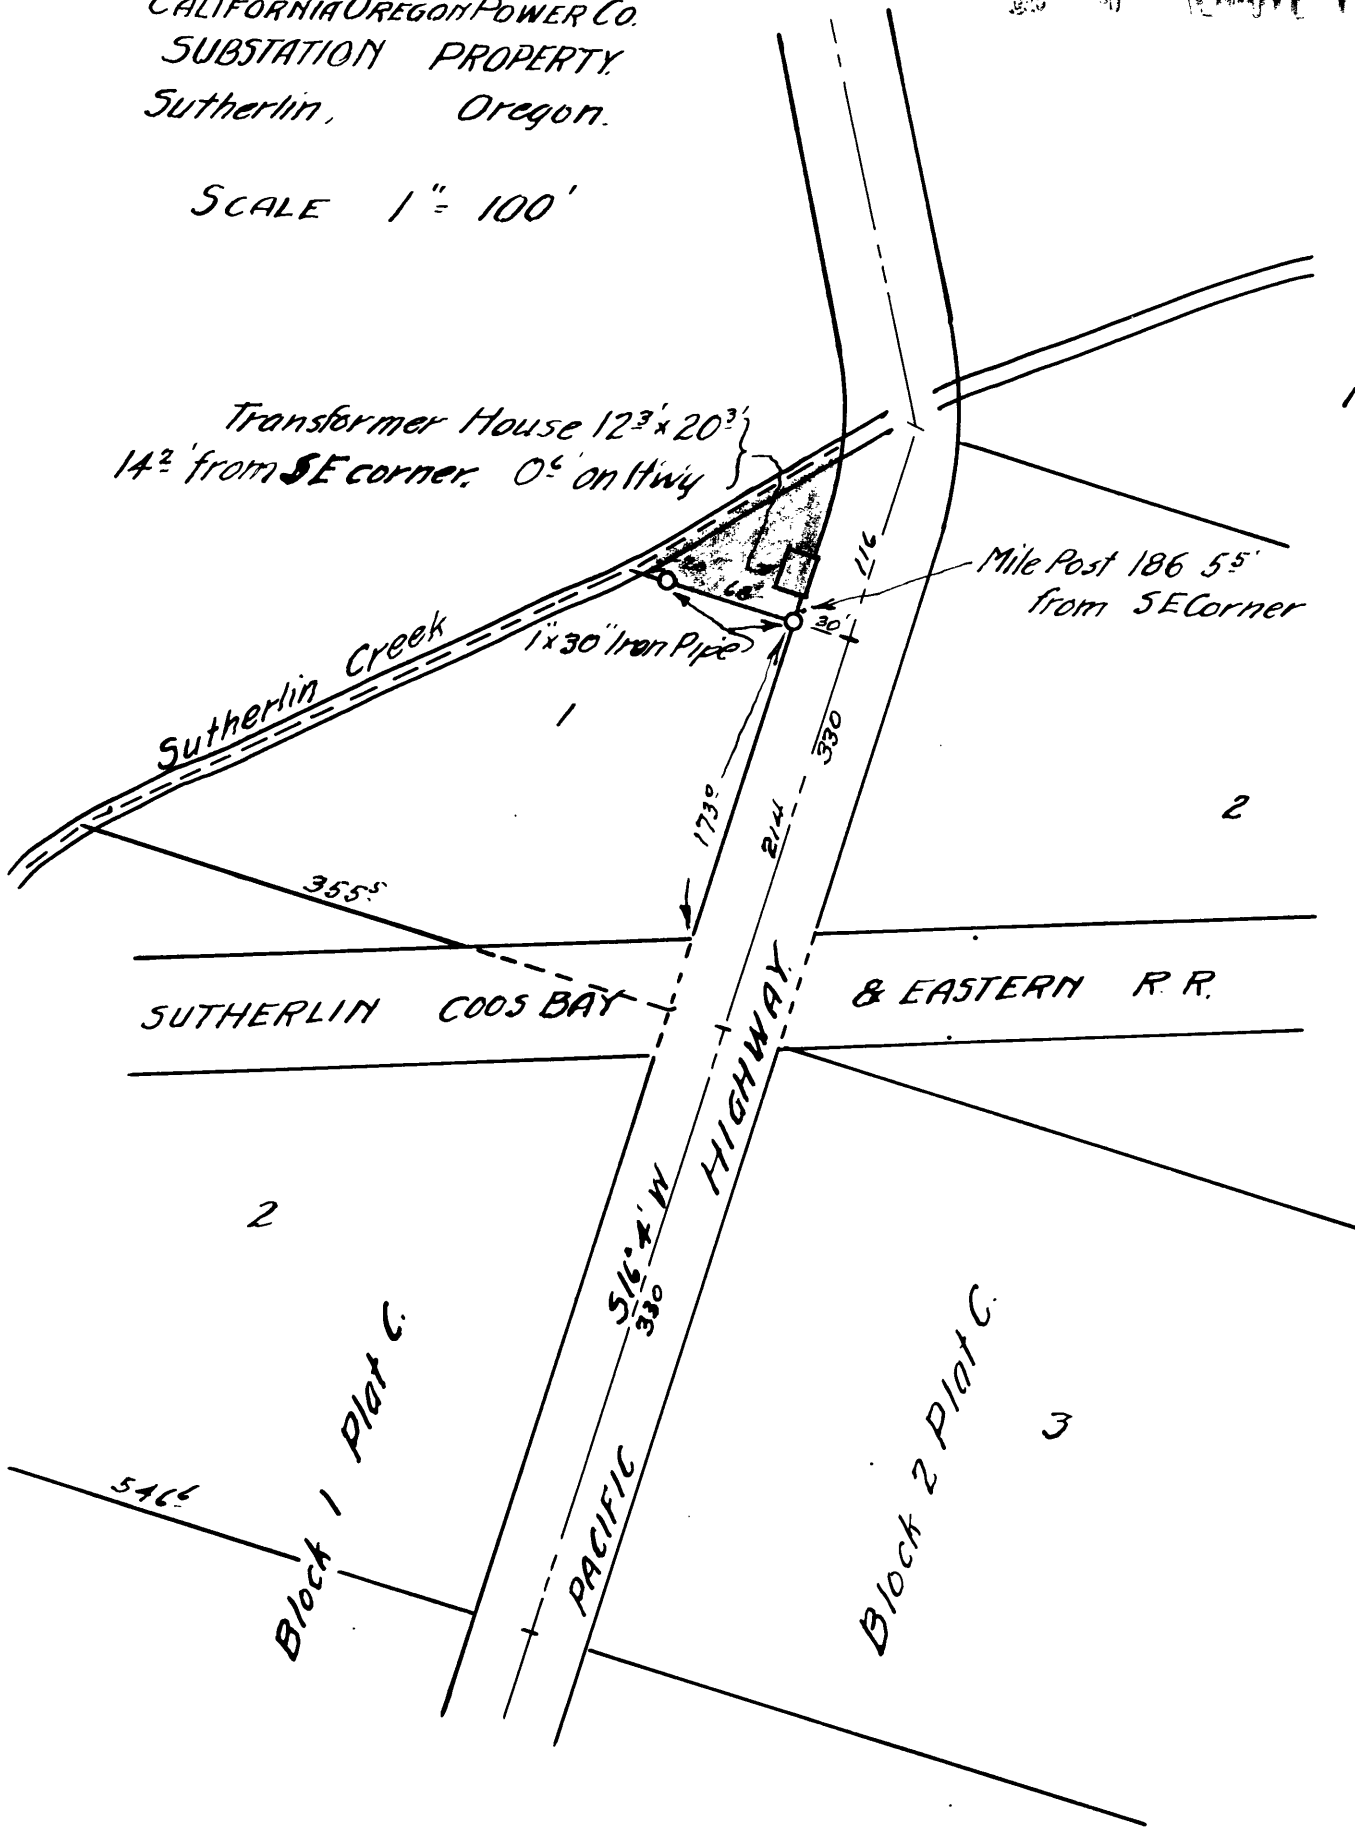

Transformer House 12<sup>3</sup>' x 20<sup>3</sup>'  
14<sup>2</sup>' from SE corner. 0<sup>6</sup>' on Hwy

Mile Post 186 55'  
from SE Corner

Sutherlin Creek  
1x30" Iron Pipe

SUTHERLIN COOS BAY

& EASTERN R.R.

Block 1 Plat C.

Block 2 Plat C.

Surveyed by Ben. B. Irving. Nov. 3 1930.