

Sec. 10 T 275 R 4 W .

CL Broughton Co Frank Stroder

C. S. File No. 37/41

Hub	CL Branta	Frank	Straden	Slope
	Sbs	L	CC	MC
9 72.169	10.756		N 3° 8' W	N 1 1/2° W +7° 40' 2872 +2° 50' 5.000 -13° 33' 3.000
8 61.413		4 19 2° 20' L		L 4.170 8.722 2.120 22° 5.000 24° 10' L 7.190 -6° 50' 2250
* 14.798		4 53 2° 26' L	N 0° 48' W	S 2 1/4° W N 1 1/2° E -6° 50' 2250
7 46.615	6.569	0° 27' 11' L	N 1° 38' E	N 2 1/2° E +8° 35' 1641 +7° 33' 5.000
6 40.046	16.935 7.935	6 52 3° 26' R	N 1° 49' E	S 2 1/4° W L 3.100 -18° 43' 5.000
5 32.111	15.267	7 26 3° 43' L	N 1° 37' W	S 1° E N 3 1/4° W -18° 22' 5.000
4 16.844	1.328	7 06 3° 33' R	N 2° 6' E	S 3 1/2° W N 2 1/2° E -18° 22' 5.000
3	6.569	7 06 3° 33' R	N 1° 27' W	S 1° E N 1 1/2° W +4° 47' 1586 5.000
2	8.947	27 0° 13' 1/2 R	N 1° 40' W	S 1° E N 0° 10' W +28° 30' 4.500 +3° 15' 5.000
1				Var 2 1/4° E

4-3-1931

Irving T
Richardson HC
Stader W
Danton, Plag

99106 - 2846
99878 499390
97217 291651
12756

98902 - 4124
92718 7966
91236 4562
1190
99290 - 2234
14798

98880 162362
99133 494665
66693

97717 483560
310
7

94911 449910
95061 475305
94906

474430
4770
4753
4774
15267

99652

87882
99939
999195
39546
39546

87882
439410
351328
3954690

9929
223
29625
19858
232025

92718 212
1112616
185436
19656216
91236 41242134
456180 80
155
650

1407 3
9888 6
13128
13128
73128
14768
16226208

3 43
2 11
2 26
2 20
8 40
7 12
1 28
1 40

3 13
3 33
3 26
7 12

99652
498260
1726
6569

set up 6 BS 5

Apr 3 1931

	Vert	Horiz	M.C.	Time
1-D	41-46	45-59 ^R	S 47° W	2-31
2	41-35	46-21 ^{1/2}	S 48° W	2-32-15
3	41-26	46-38	S 48° W	2-33-15
4	41-15	47-05	S 48 ^{1/2} W	2-35
5	41-07	47-19	S 48 ^{1/2} W	2-36

	1	2	3	4	5
Vert A	41° 46'	41° 35'	41° 26'	41° 15'	41° 07'
Ref -	1' 4"	1' 5"	1' 5"	1' 6"	1' 7"
Parallax +	6"	6"	6"	6"	6"
Log Cos.	9.972772	9.974009	9.975814	9.976236	9.977120
Log Tan	9.950625	9.947827	9.945535	9.942733	9.940694

Lat. 43° 14' 10"

Log Cos L 9.862451

Log Tan L. 9.973243

decl. Green Noon. 5° 2' 52.3"
 diff 1 hr. 57.55"
 diff 10.55 hrs
 decl. 5° 12' 54.5"

57.55
 10.55
 28775
 28775
 57550
 6011525

Log. Sin d -

8.958670

#1

60/33.5
30.5
3

46
48
50
143

<p>Log Cos L 9.862451 A 9.872722 <u>9.735223</u></p> <p>54° 15' W 45 59 <u>5 30 16' W</u></p>	<p>Log Sin L 8.958670 9.735223 <u>9.223447</u></p> <p>16728</p>	<p>Log Tan L 9.973243 A 9.950625 <u>9.913869</u></p> <p>82010 16728 <u>65282</u></p>
<p>2 9.862451 9.874009 <u>9.736460</u></p> <p>48° 40' 46 21 <u>51 49 W</u></p>	<p>8.958670 9.736460 <u>9.222210</u></p> <p>16681</p>	<p>9.973243 9.947827 <u>9.921070</u></p> <p>83382 16681 <u>66701</u></p>
<p>3 9.862451 9.875014 <u>9.737465</u></p> <p>48° 28' 46 38 <u>51 50 W</u></p>	<p>8.958670 9.737465 <u>9.221205</u></p> <p>16642</p>	<p>9.973243 9.945535 <u>9.918778</u></p> <p>82943 16642 <u>66301</u></p> <p>18</p>
<p>4 9.862451 9.876232 <u>9.738687</u></p> <p>48° 51' 47 05 <u>51 46 W</u></p>	<p>8.958670 9.738687 <u>9.220083</u></p> <p>16599</p>	<p>9.973243 9.942733 <u>9.915976</u></p> <p>82404 16599 <u>65805</u></p>
<p>5 9.862451 9.877120 <u>9.739571</u></p> <p>49° 7' 47 19 <u>51 48 W</u></p>	<p>8.958670 9.739571 <u>9.219099</u></p> <p>16561</p>	<p>9.973243 9.940294 <u>9.913937</u></p> <p>82023 16561 <u>65462</u></p>

OBT ok but Rotted.
Set Pine Limb for Corner.

14 Cr $\frac{3}{10}$
083

N 41° 5' E

10
76.904

41° 44' R

N 40° E

6.735

N 0° 39' W

N 3/4 E

+ 8° 45' 1778
+ 5° 40' 5000

9
72.169

7 36
30 47' R


N 3° 8' W

B. Oak 30' N. 66° 30' W. 152 1/2 lbs
 W " 8' S. 13° 45' E. 66 1/2 "

98836 - 1757
 99571 - 497555
 6.733

98836 7
 1778 5
 790688
 694852
 641852 5
 98836
 175730408 ✓

C. S. File No. 37/41

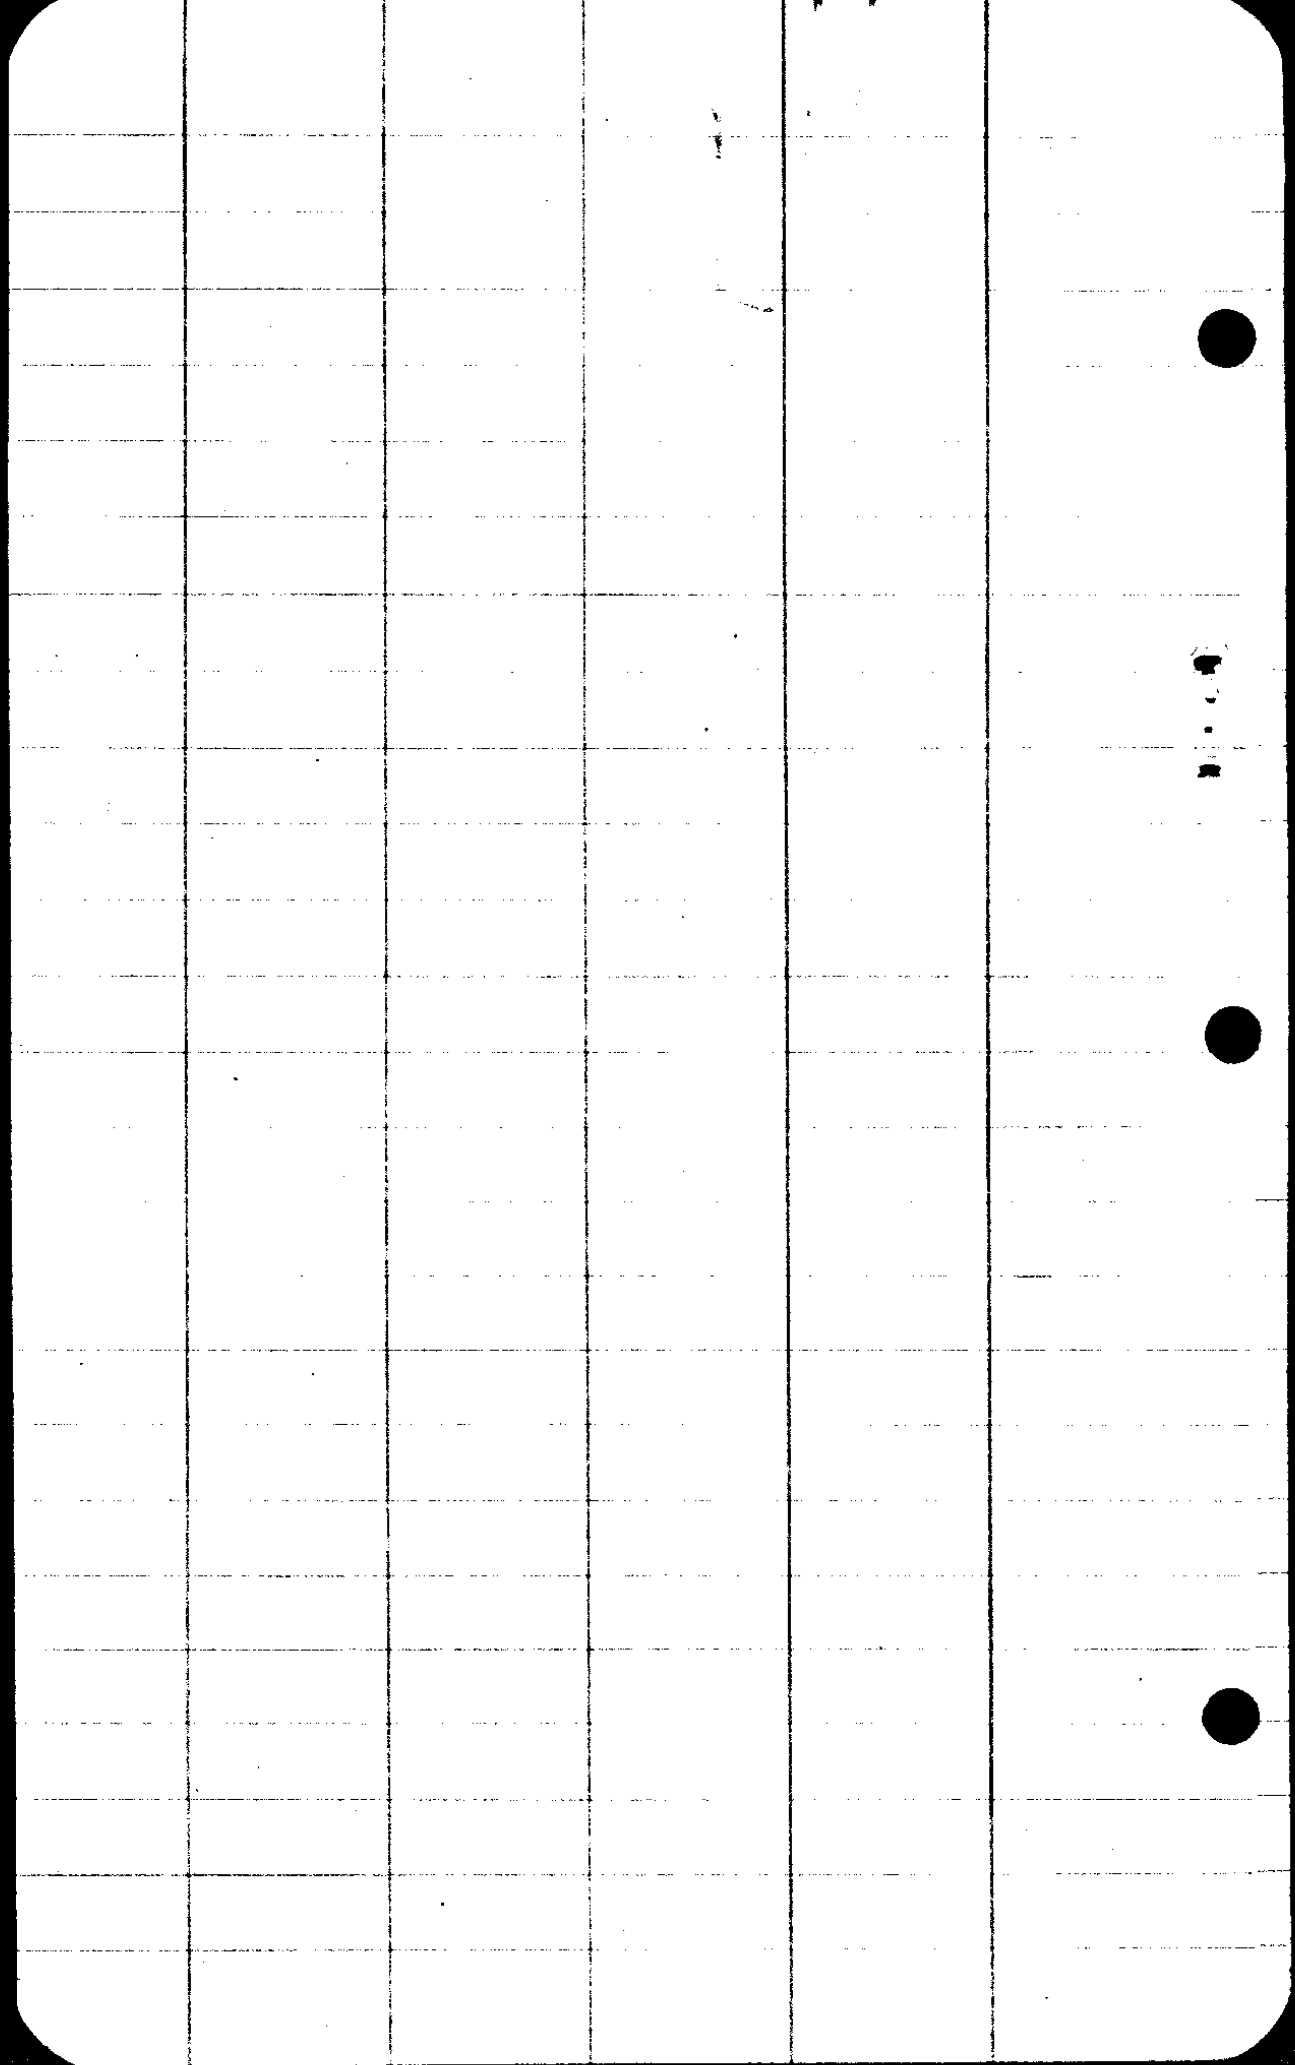

CS FILE FOLDER

CONTAINS

MORE

INFORMATION