

Dan B. Boone

June 8-1932


N. E. Richardson Transit

B. A. Lane Chain

Q. S. 37/72


2nd Ave South

↑ I. Pipe.

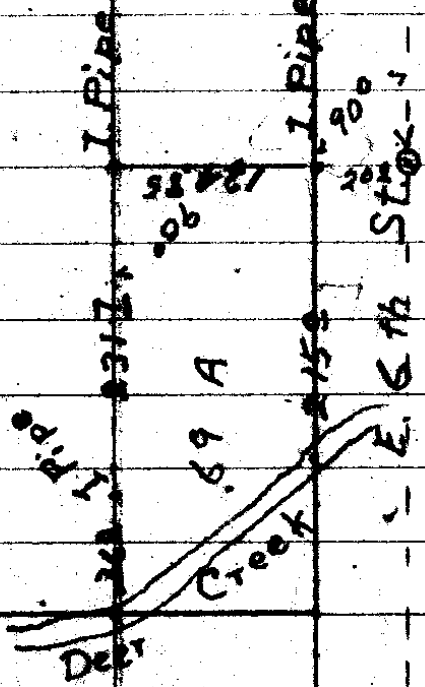

P

Roselund to City Roseburg.
 Boone
 P.M.
 M & B Ct 5347 Dec. 23 - 1936
 Roselund
 Ct 5078 Epp
 Bert.

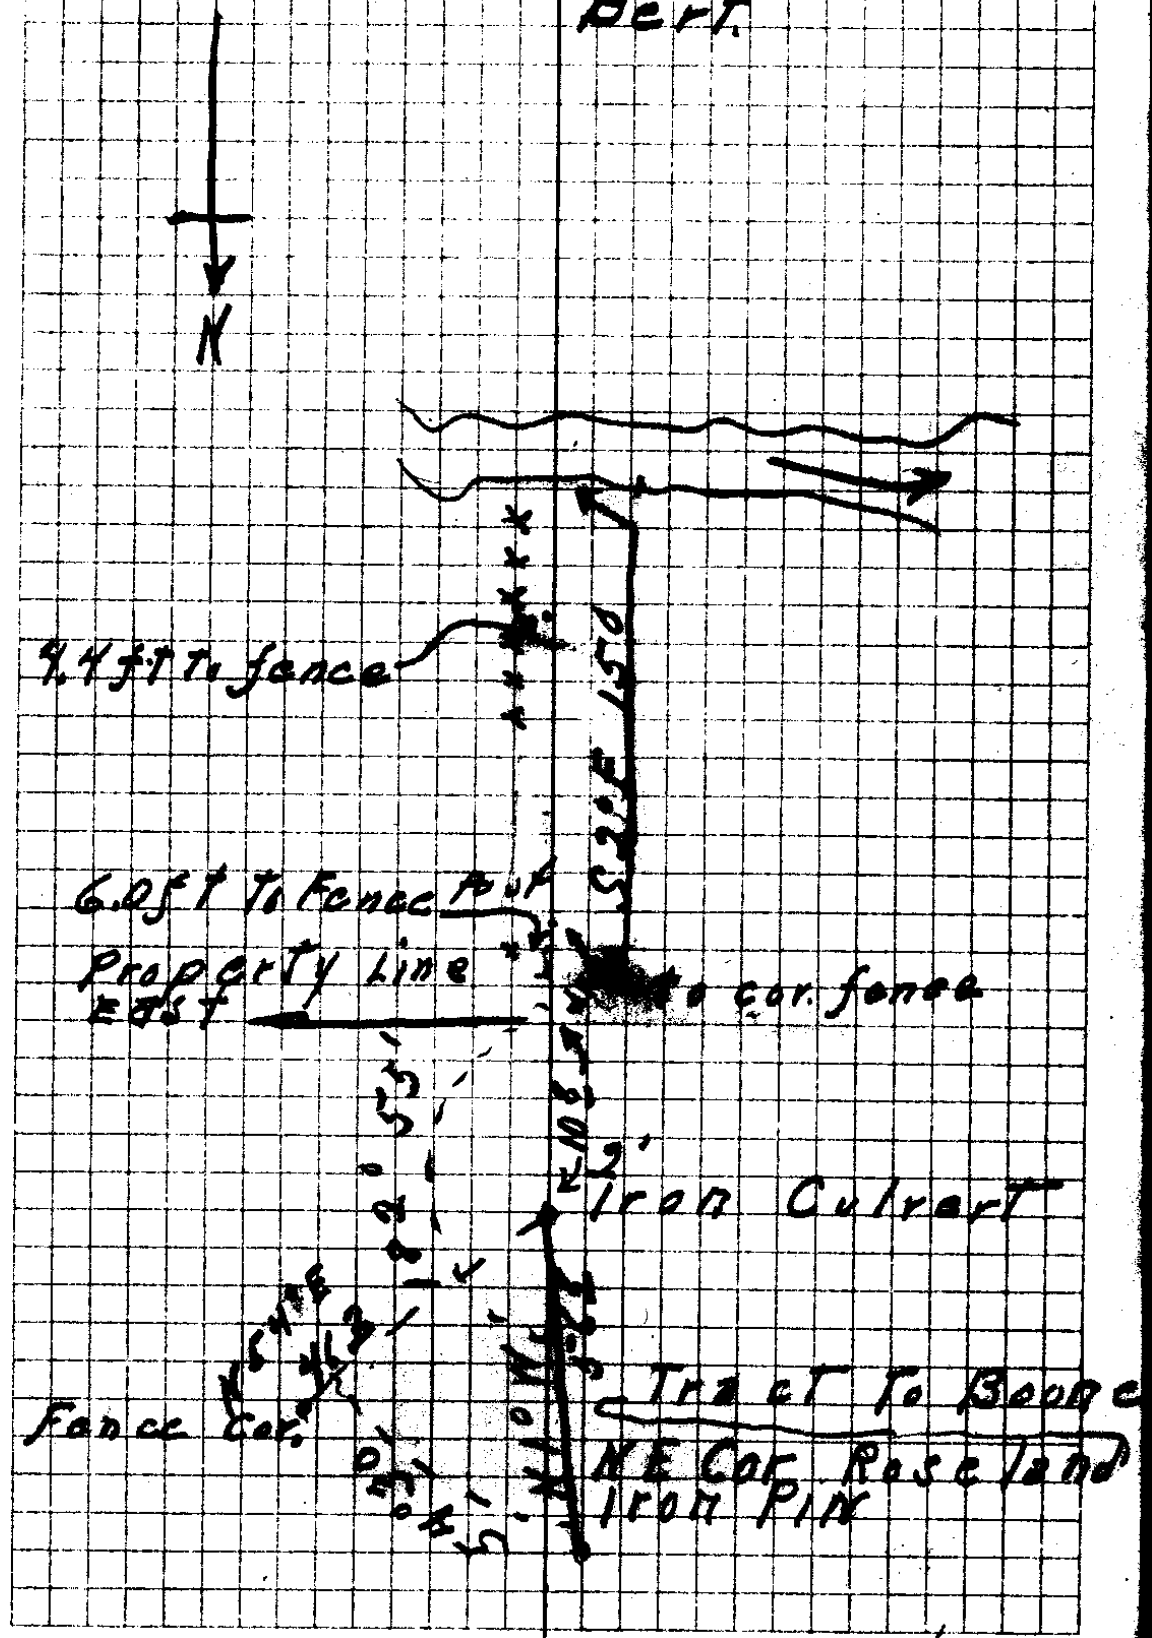

CS FILE FOLDER

CONTAINS

MORE

INFORMATION