


**COUNTY SURVEYORS FILE DATA  
DO NOT REMOVE FROM OFFICE**

PART OF  
T 25 S R 7 W WM  
Showing  
TIE FROM NE CORNER OF  
40 A TRACT  
to  
1/4 Sec. Cor. bet. 24 + 25  
Dec. 12 1932  
BEN. B. IRVING  
Dep. Co. SURVEYOR.

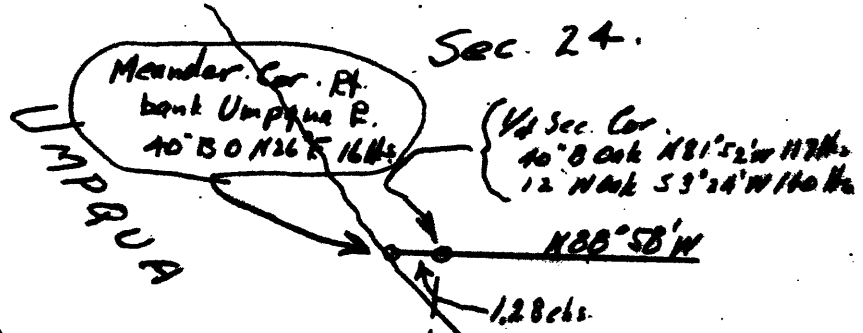

Rock from which  
B oak 14' dia S 68° E 17 1/2 chs  
B oak 8' - N 87° E 90 chs

Sec. 25  
Note: -  
Bearings of  
tie line and RTs  
at 1/4 Sec Cor +  
Sec. line taken  
from direct Solar  
observation 12-12-1932  
BBJ

