


37/89

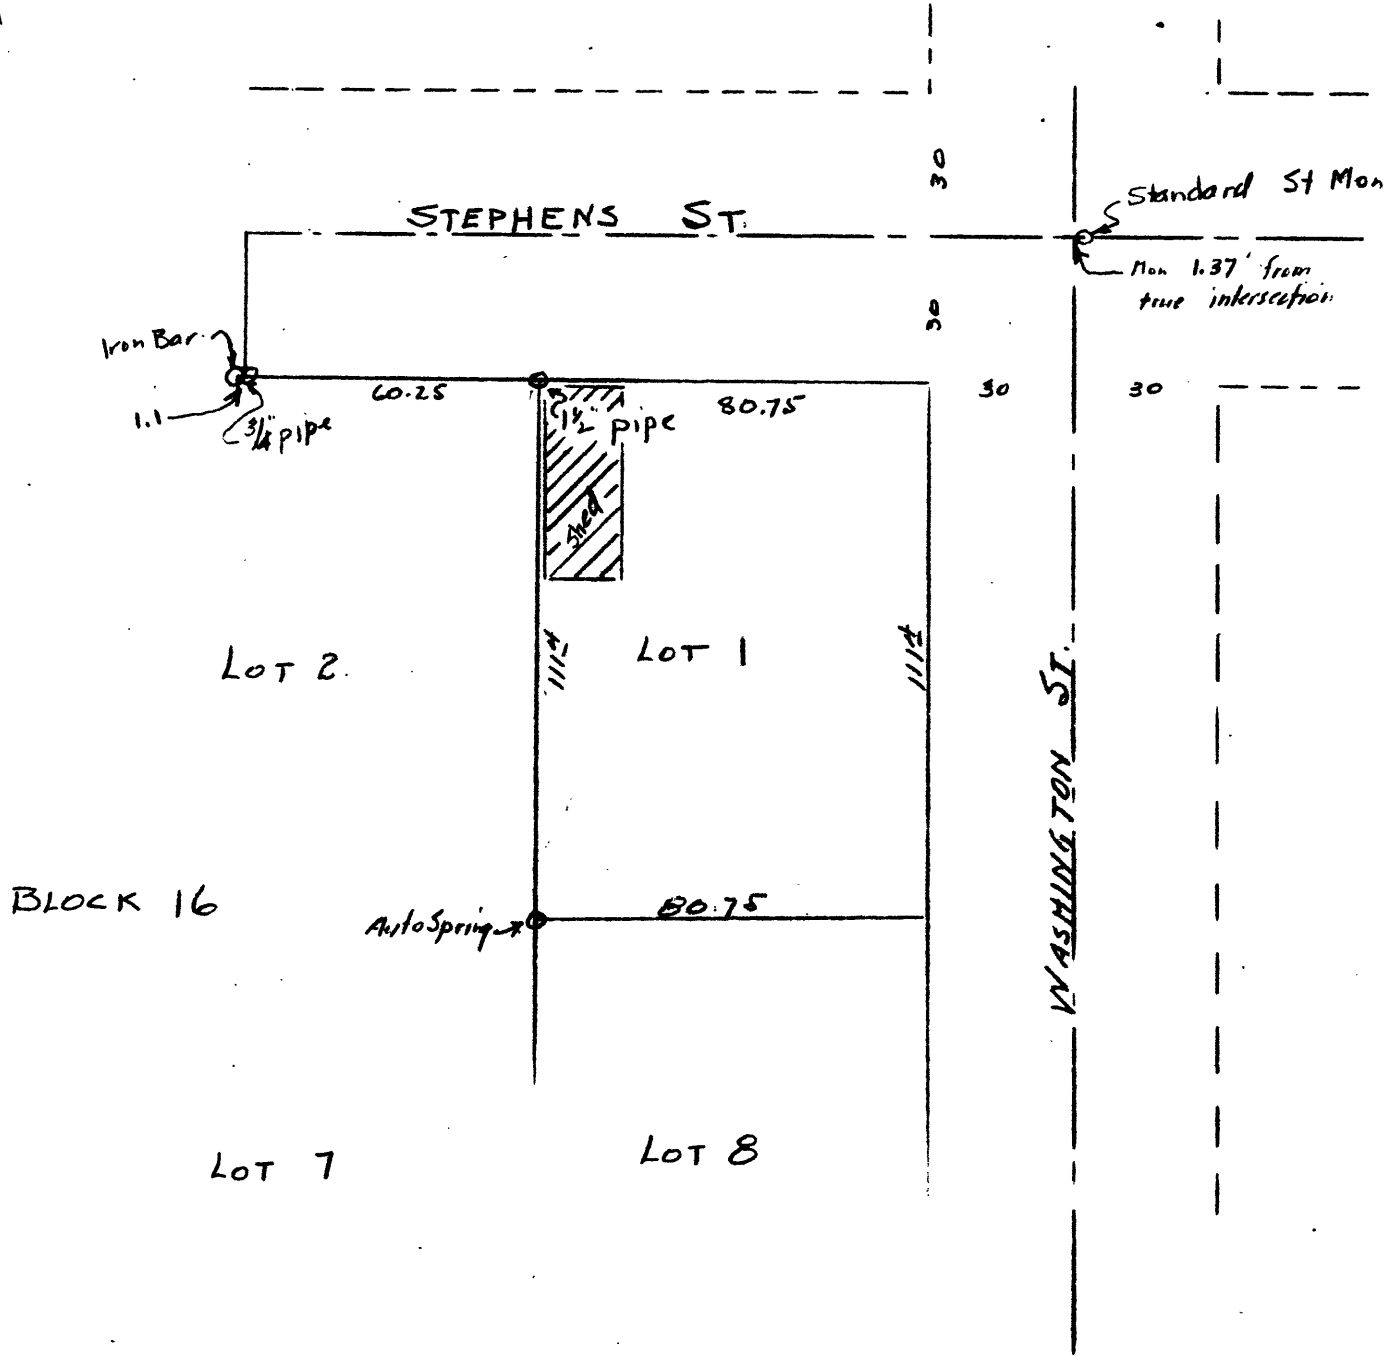

ALDEN HARNESS

LOT 1 BLOCK 16

AS SURVEYED BY

BEN B. IRVING CITY ENGR.

DEC. 8 1932

COUNTY SURVEYORS FILE DATA
DO NOT REMOVE FROM OFFICE

SCALE 1" = 40'

C. S. File No. 37/89