

Check Survey

Lots 1 & 2

PLAT A

Millers - Dillard - Subdivision

Nov. 25 1939

T B B Irving

NE NE Richardson

RF. RL. Irving

C.S. File No. 37/106 B

Δ 6

100°

574° 18' W

ht 134° 15' 8" PIPE ON R/W LK

Δ 5

100°

11 5° 35' L

ht 23° 13' 19" Bayers Pipe Dead Desc

579° 53' W

Δ 4

100°

12 3d 6° 17' L

586° 10' W

Δ 3

100°

9 5d 4° 57' L

N 88° 53' W

Δ 2

300°

9 0d 4° 33' L

R/W Fence 7' ht

N 84° 20' W

Δ 1

388°

18 1d 90° 37' R

55° 03' W

I P.

90° R

45 1/4

584° 57' E

I P.

4821

1' offset R+ (E)

10109
137

IP 5717

IP 5252

NW Cor Lot 2

374 6

NNW Cor Lot 1

1010.9

N46°45'E

OIP

346 49
173 24 R

123 3

10.28 553°21'W
5°14' L

ID

100

7.28 558°35'W
3°44' L

A9

100°

6.19 562°19'W
4°09' L

A8

100°

5.59 566°28'W
2°59' L


A7

100°

9.42 569°27'W
4°51' L

A6

579 18 W

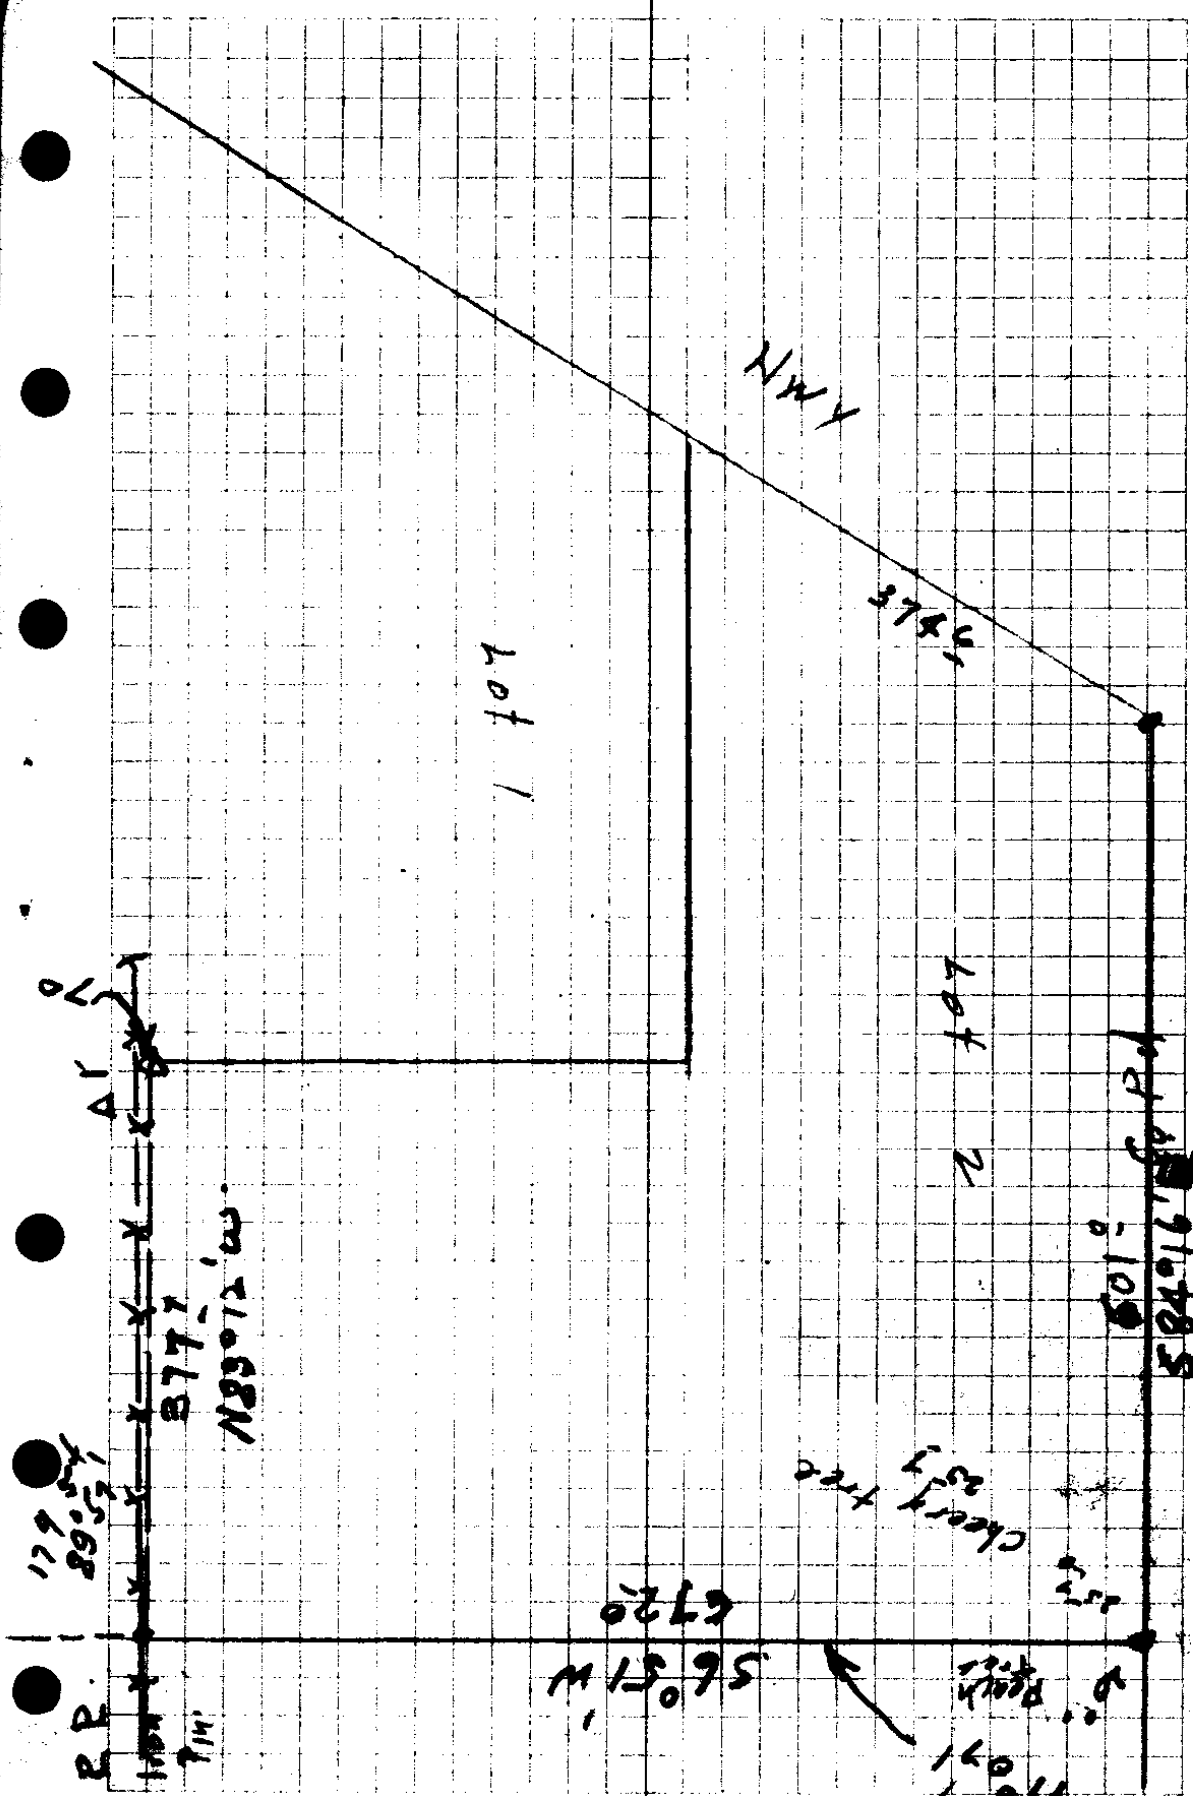

179
89°53'

R.P.

3777'

N89°12'W

S60°51'W
6720

Clear tree

120°16'
910°21'

584916' Rd

C. S. File No. 37/1068

CS FILE FOLDER

CONTAINS

MORE

INFORMATION