


NORTH UMPQUA RIVER

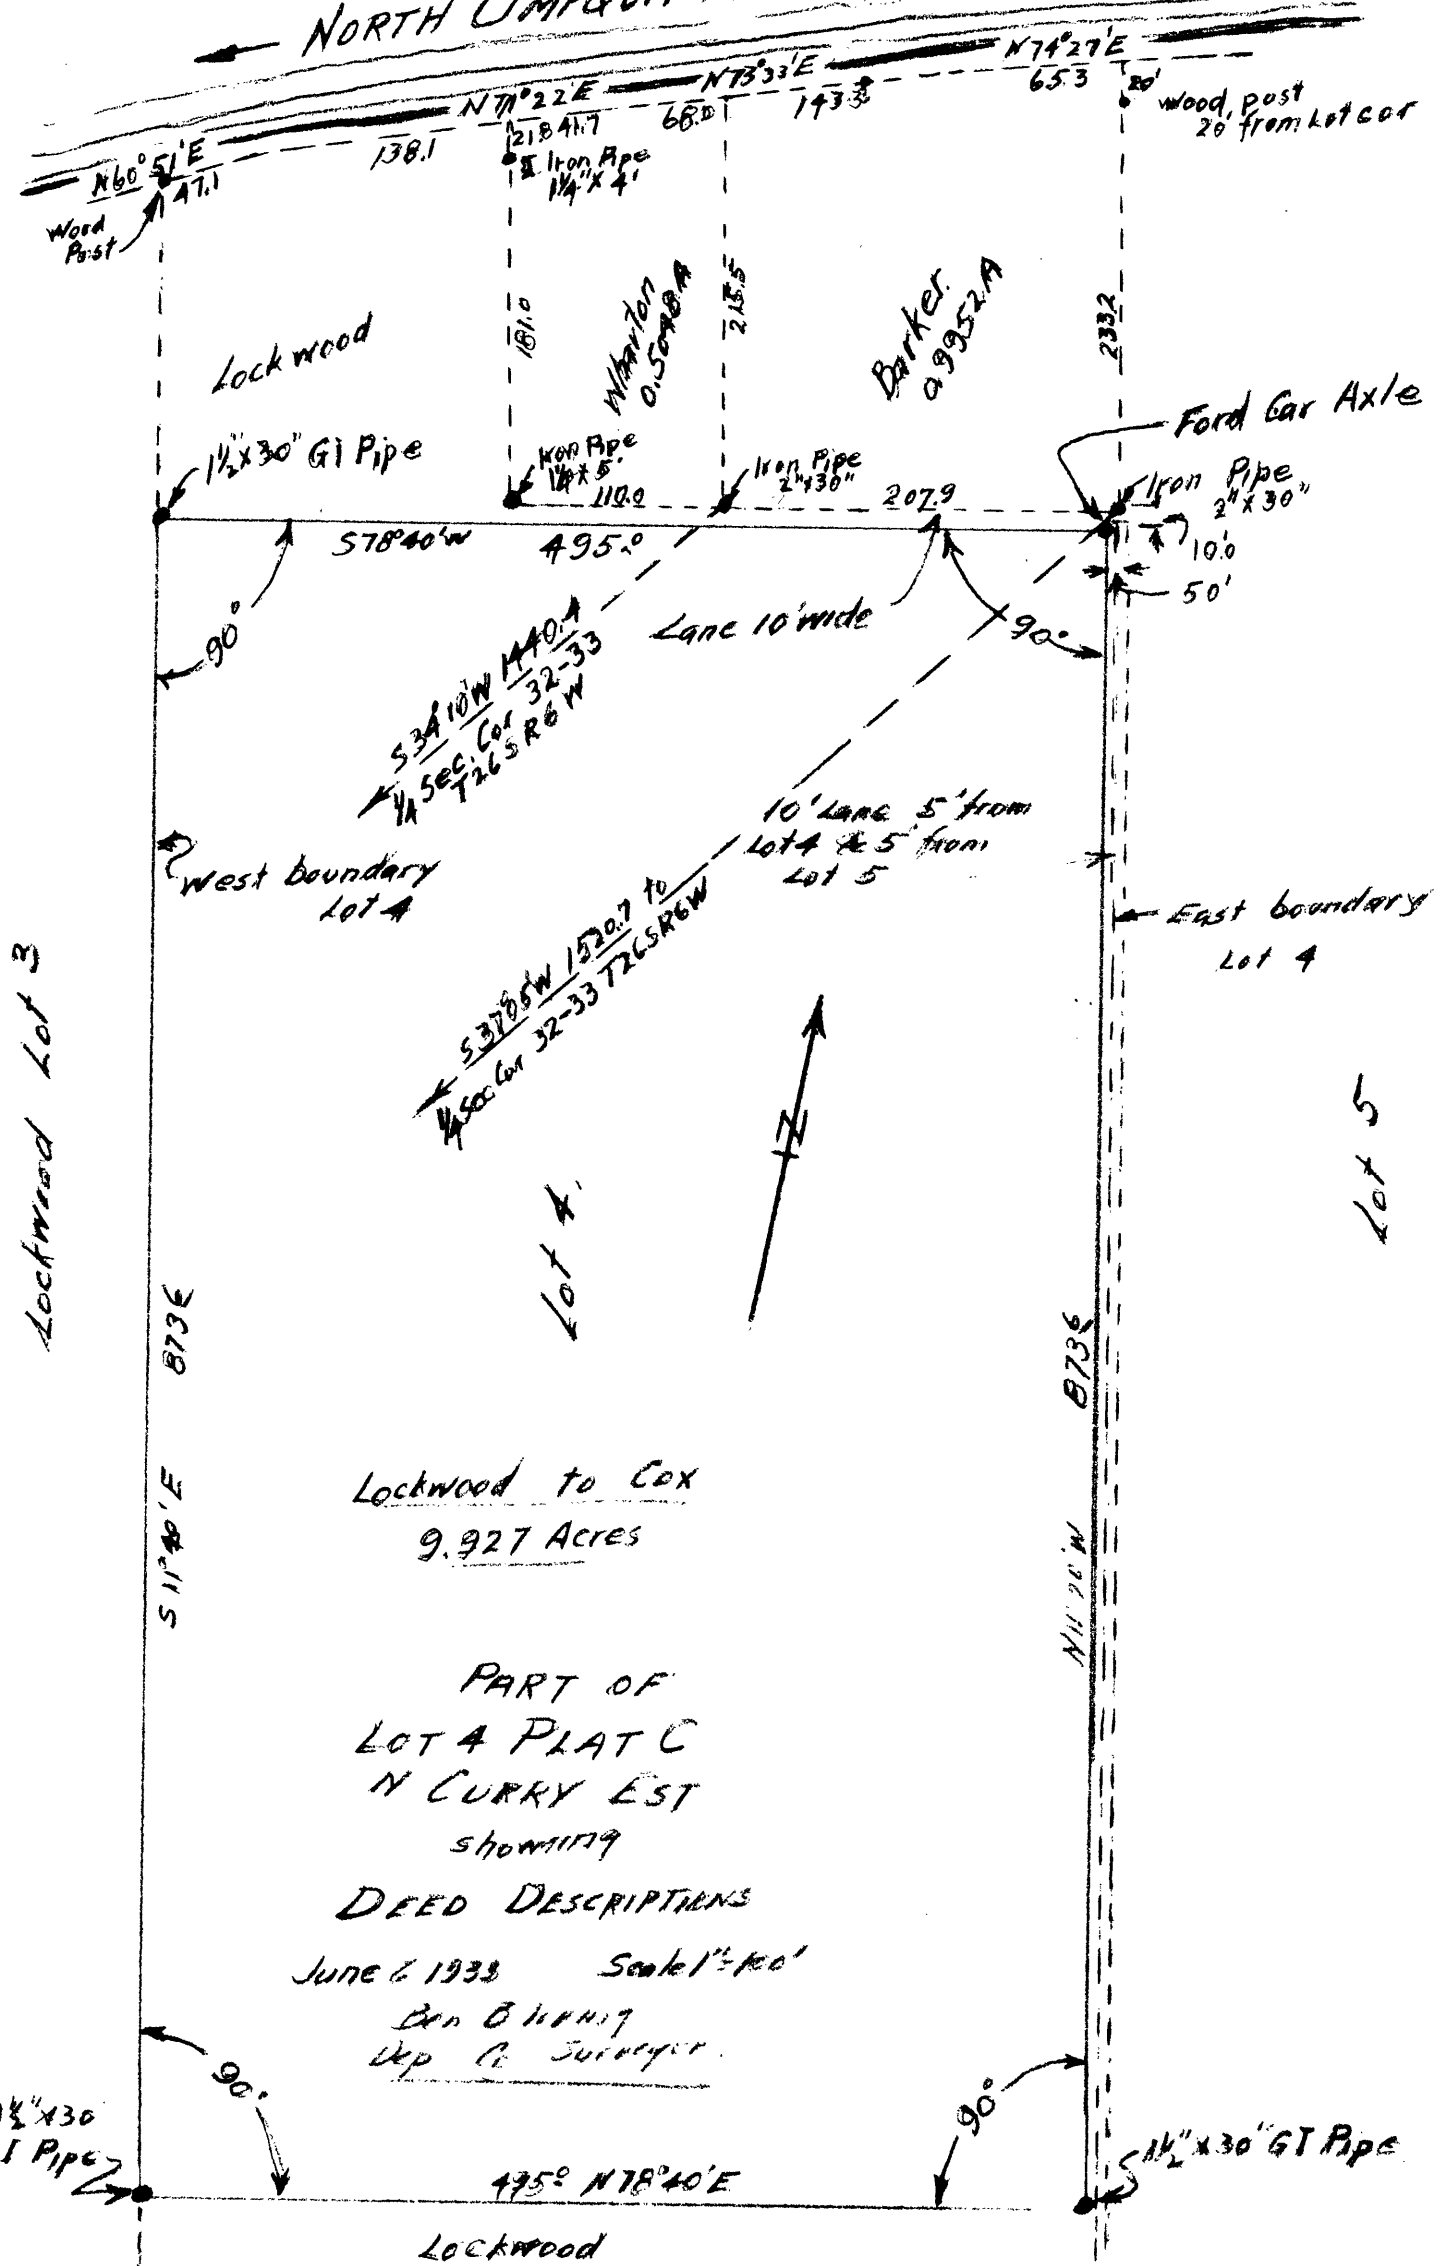

Lockwood to Cox
9.927 Acres

PART OF
LOT 4 PLAT C
N CURRY EST
showing
DEED DESCRIPTIONS

June 6 1933 Scale 1" = 100'
By B. H. H. H. H.
Dep. Co. Surveyor.

$1\frac{1}{2} \times 30"$
GI Pipe

$1\frac{1}{2} \times 30"$
GI Pipe

Lockwood