


sec. 24, T 27S, R 6W.

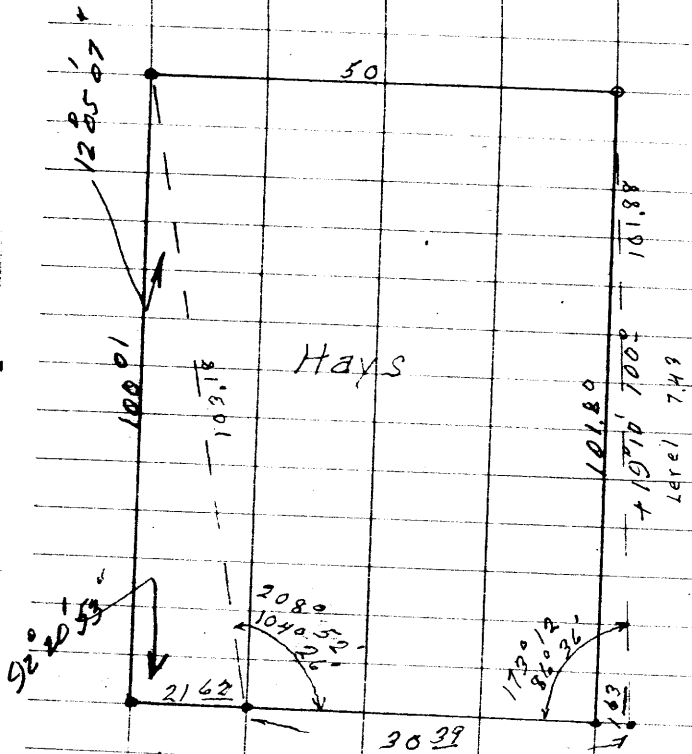

Hays

By ERNSTEN