


COUNTY SURVEYORS FILE DATA
DO NOT REMOVE FROM OFFICE

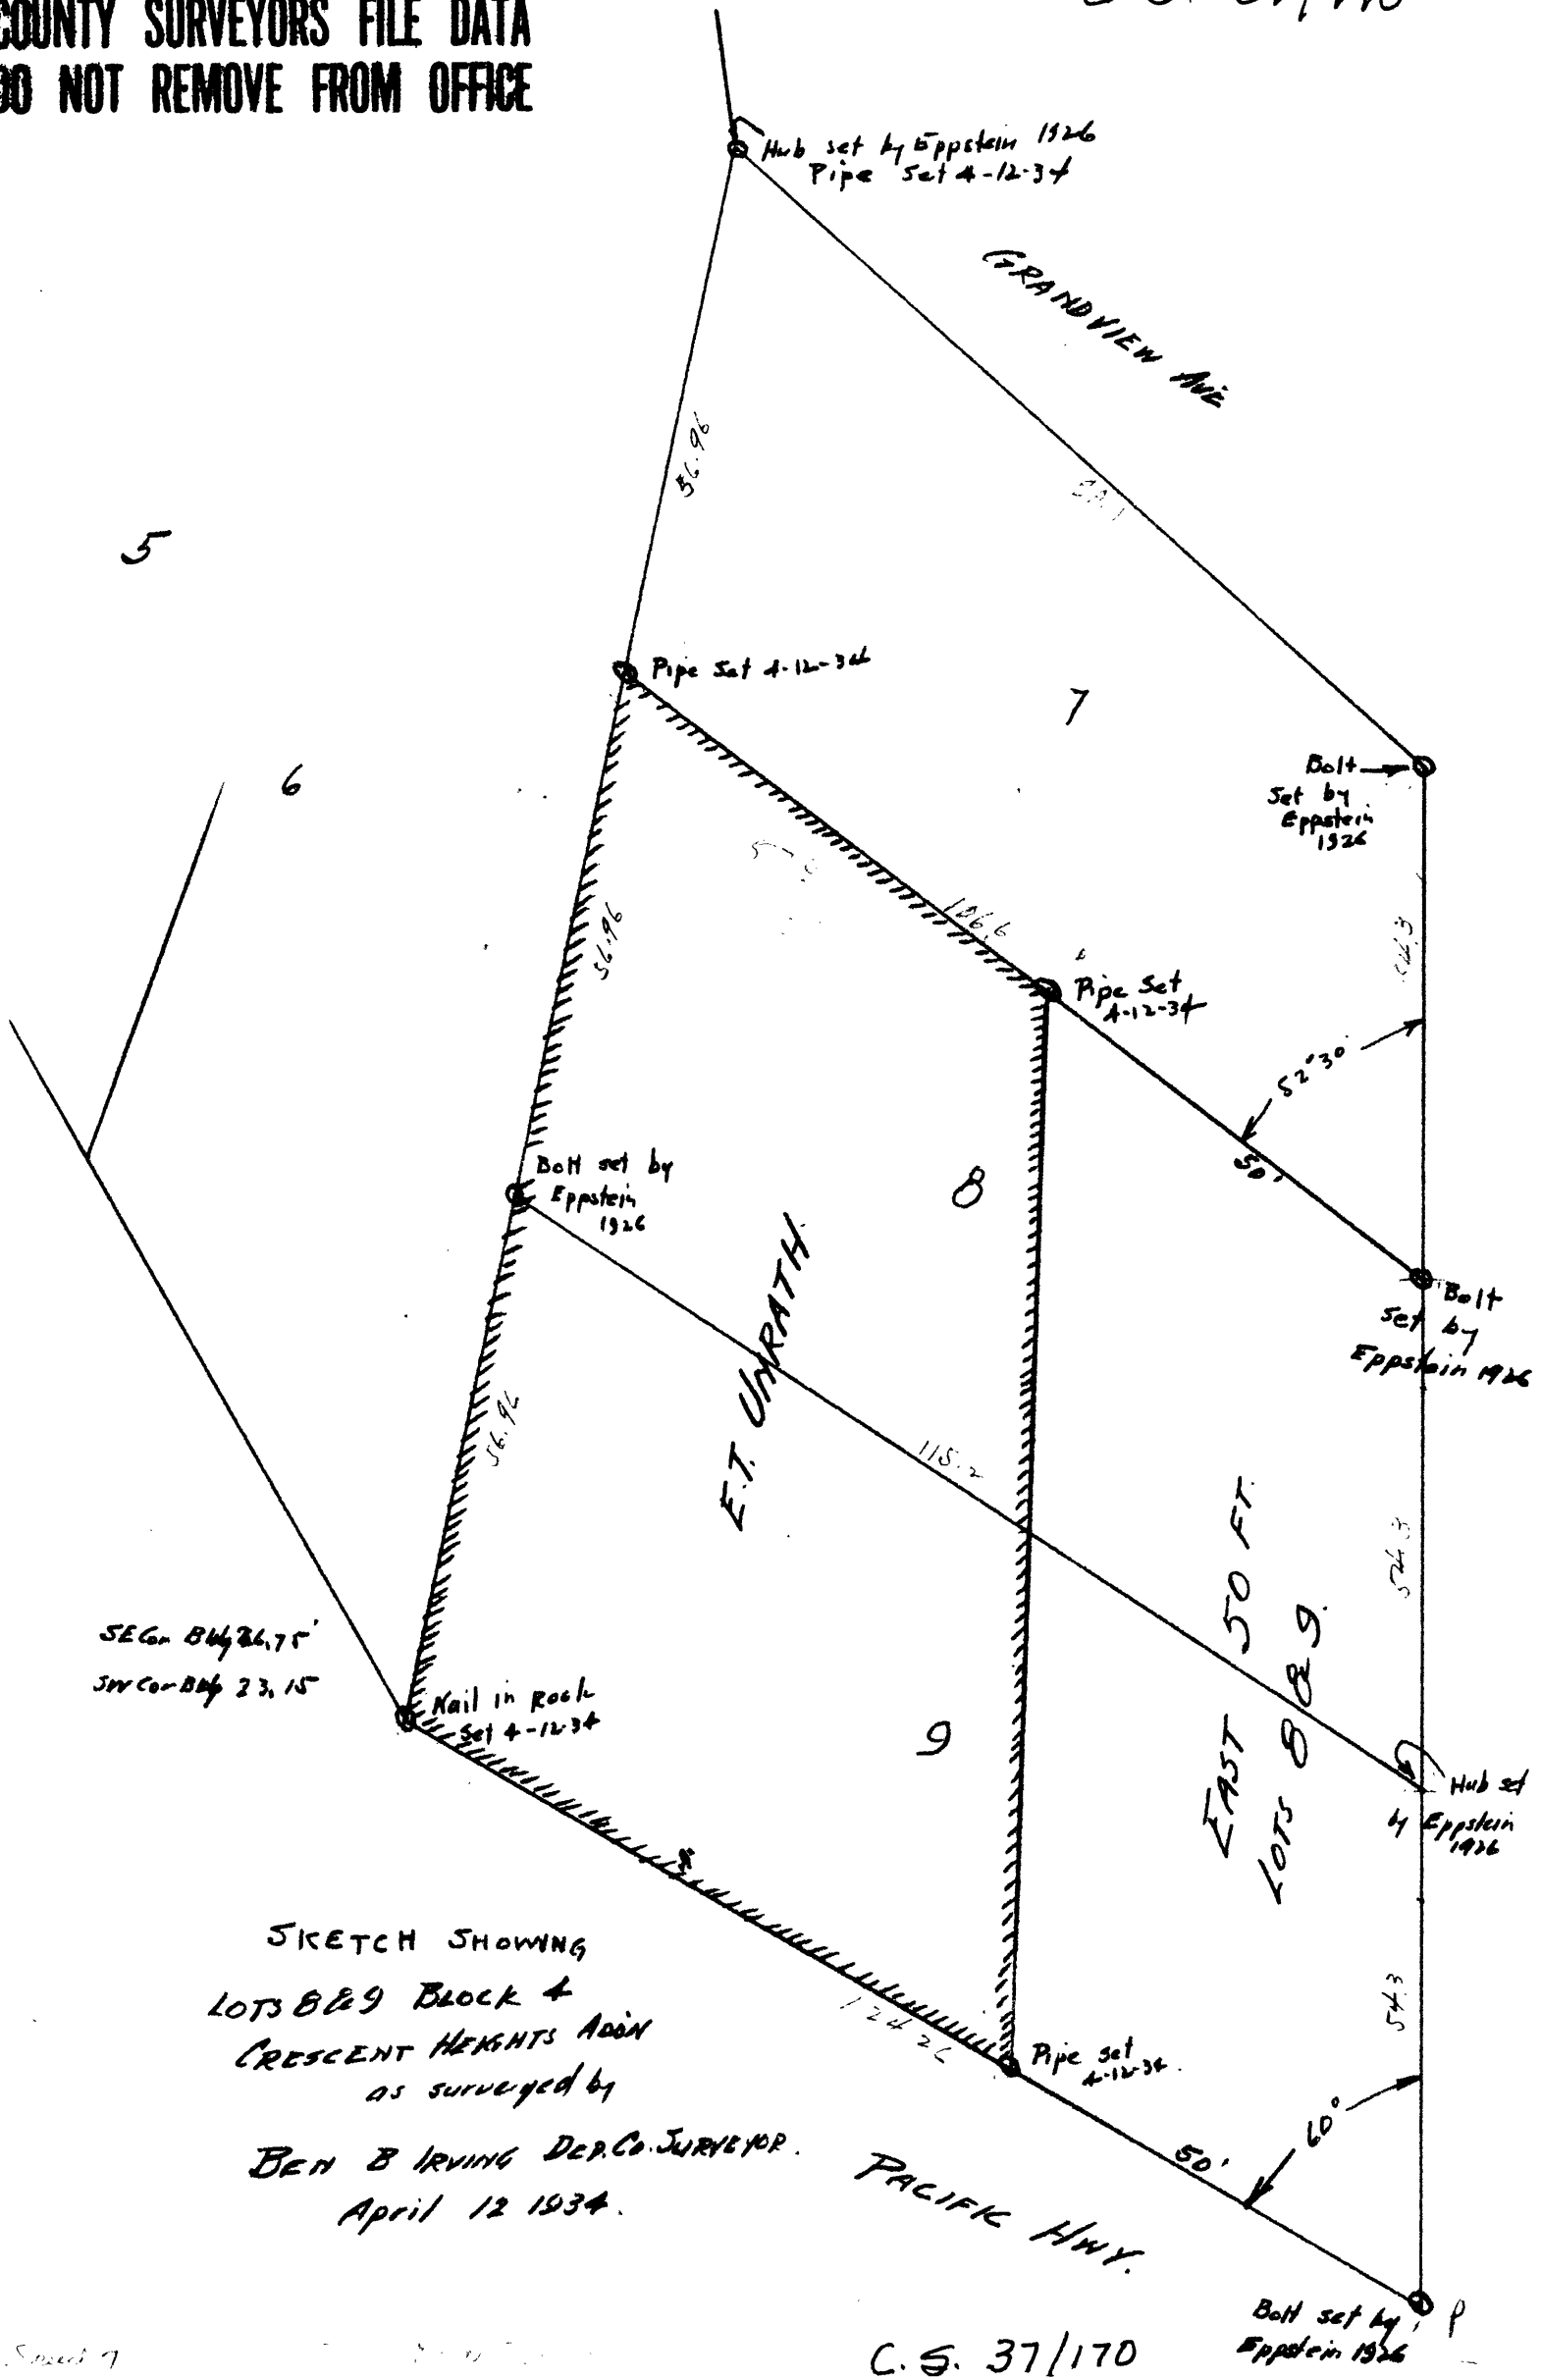

SKETCH SHOWING
LOTS 8 & 9 BLOCK 4
CRESCENT HEIGHTS ADDN
as surveyed by
BEN B IRVING DEP. CO. SURVEYOR.
April 12 1934.

PACIFIC HWY.

Bolt set by Eppstein 1926