

BLOCK "C" PLAT "J"
 SUTHERLIN LAND & WATER CO.
 SCALE 1" = 50'

FRANK L. YOUNG

**COUNTY SURVEYORS FILE DATA
 DO NOT REMOVE FROM OFFICE**


H.O.L.C. No. 12185 FRANK L. YOUNG SUTHERLIN, OREGON.
 All of Lots 4 & 5 in Block C Plat J, of the SUTHERLIN LAND & WATER CO.

Nov. 10, 1934

I, BEN. B. IRVING, hereby certify that I have ~~surveyed~~ ^{inspected} the property above described and that the above plat illustrates the conditions as to improvements and encroachments, if any, existing on this date.

Ben. B. Irving
 Registered Professional Engineer.

STATE OF OREGON No. 240
 NOVEMBER 8, 1919.

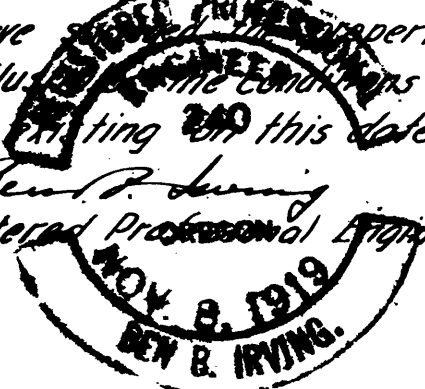

CS 37/206-4
 P