



COUNTY SURVEYORS FILE DATA  
DO NOT REMOVE FROM OFFICE

SECTION 20  
T. 32 S., R. 3 W. W.M.

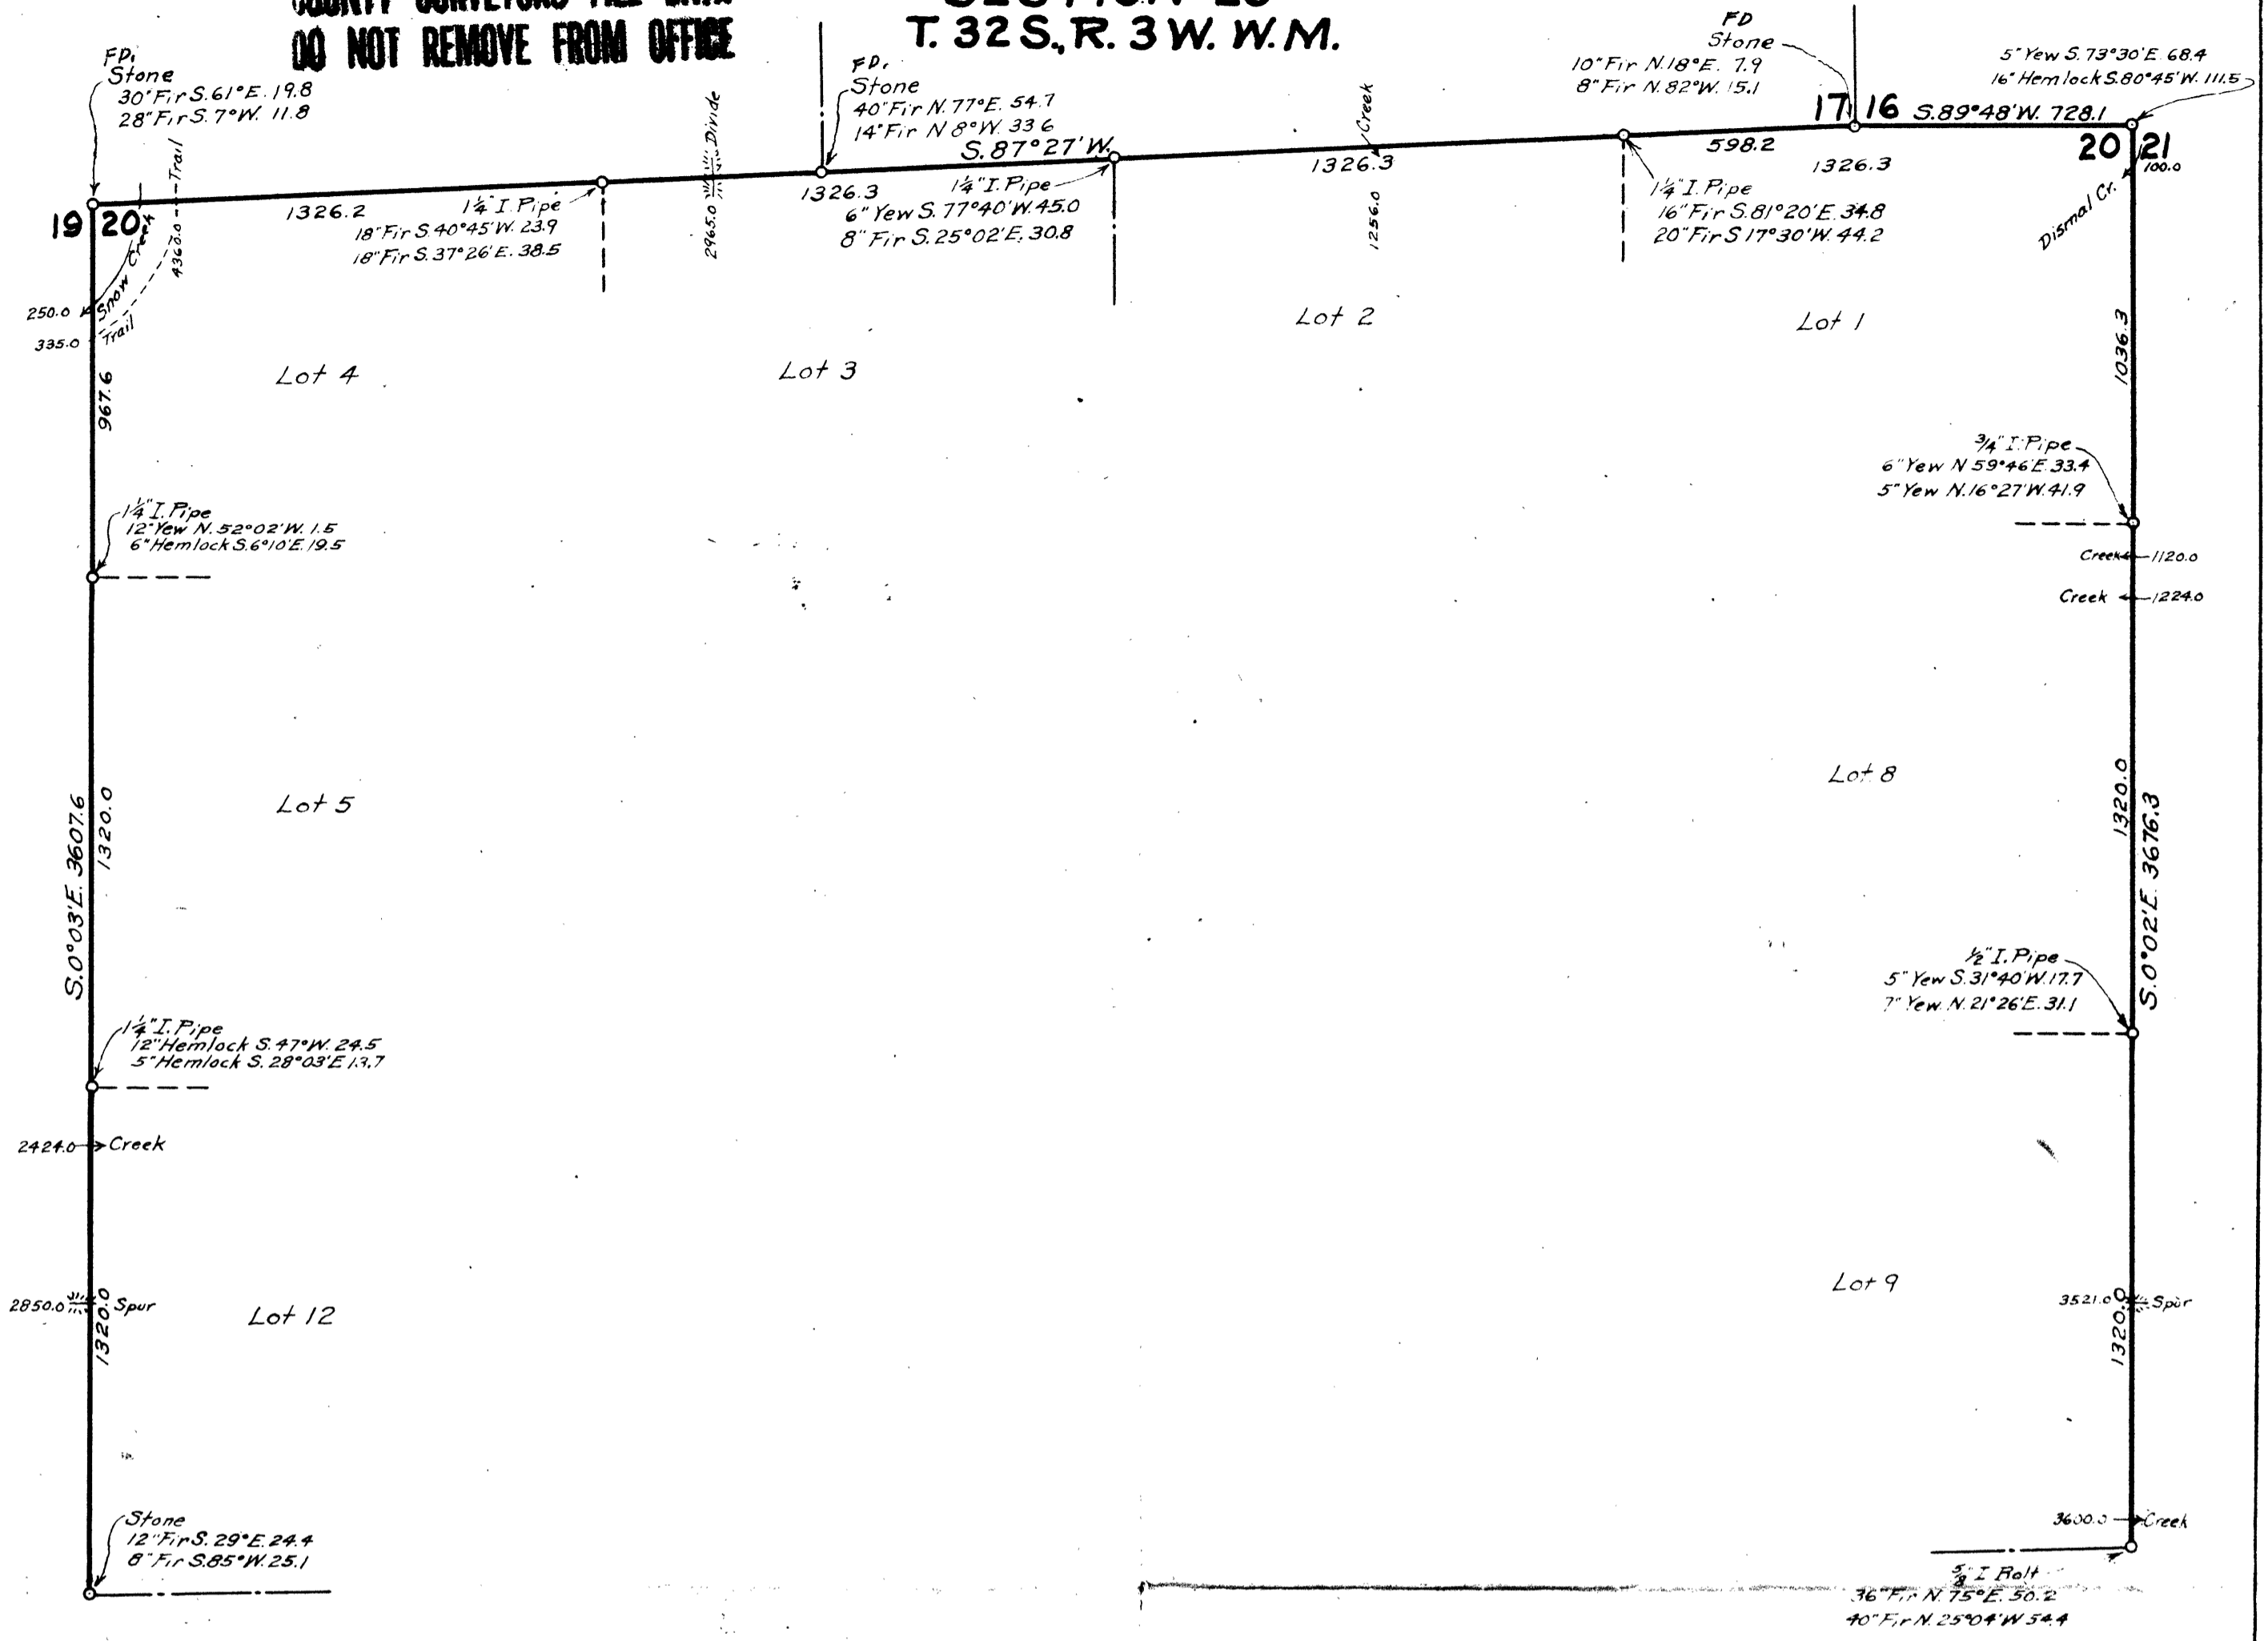

COUNTY SURVEYORS FILE DATA  
DO NOT REMOVE FROM OFFICE

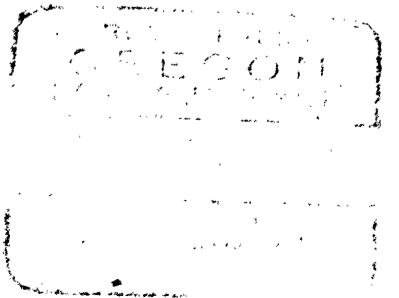

WENDEROTH  
1945

4A  
FILE #4 DRAWER 38