
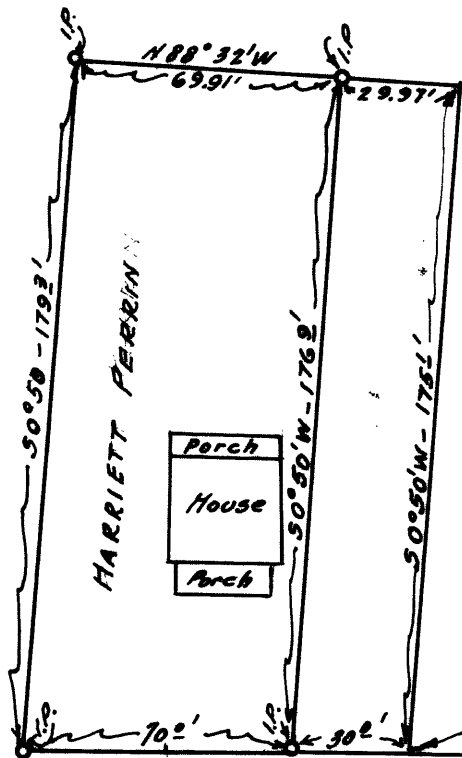


COUNTY SURVEYORS FILE DATA  
DO NOT REMOVE FROM OFFICE

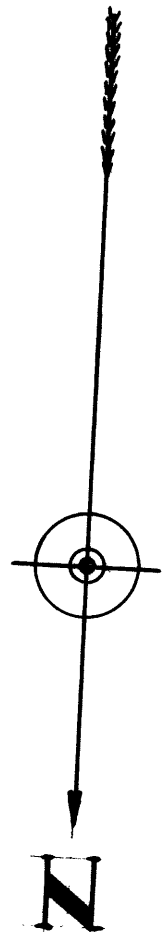

# MAP

SHOWING HARRIETT PERRIN PROPERTY.

1127 HARVARD AVE

ROSEBURG OREGON

SCALE - 1" = 50'

JAN. 1946.

