



TRANSIT SHEET

FORM 883-5M-3-44

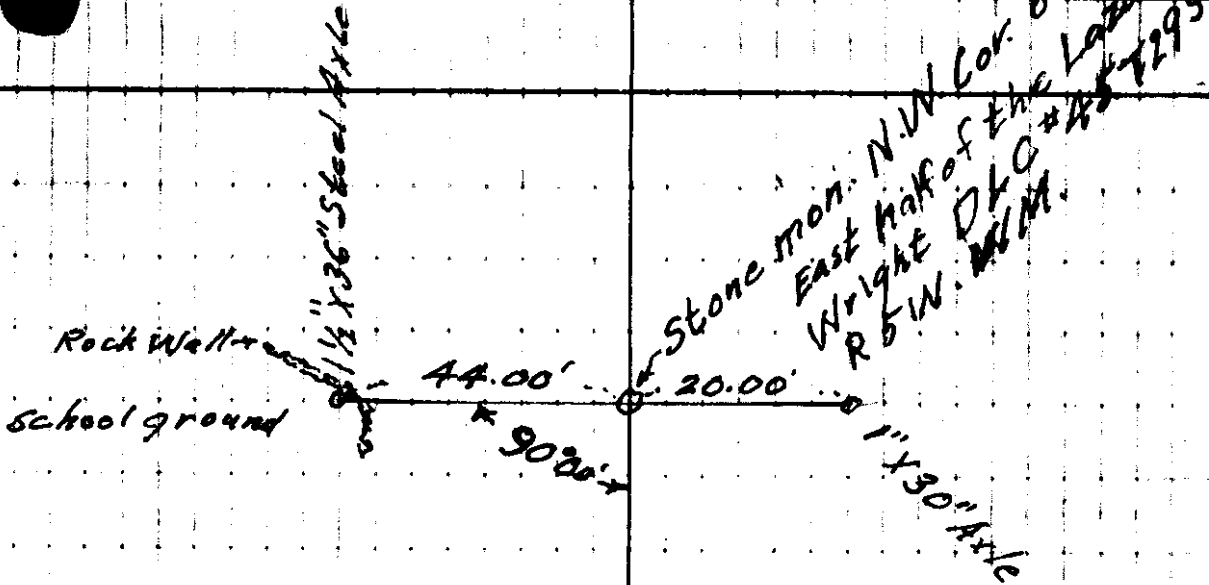


S 68° 55' 1/2" E

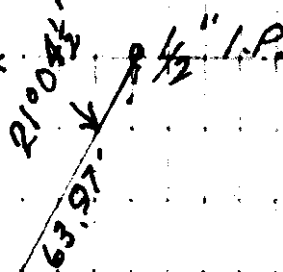

Sec. Cor. 21/22
28/27

REGISTERED
OREGON
LAND SURVEYOR

George C. Baker
JAN. 1, 1943
George C. Baker
77

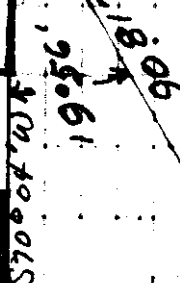

E.S. 38/111