

T-C. S. Collins

AUG. 6. 1946


Ch- { B. MS Namee
Ed Boyer

1

Mag Var used

21° 15' E

Found remains of old 4"x4"
post set in concrete.
Used for NE Cor. D.L. #91

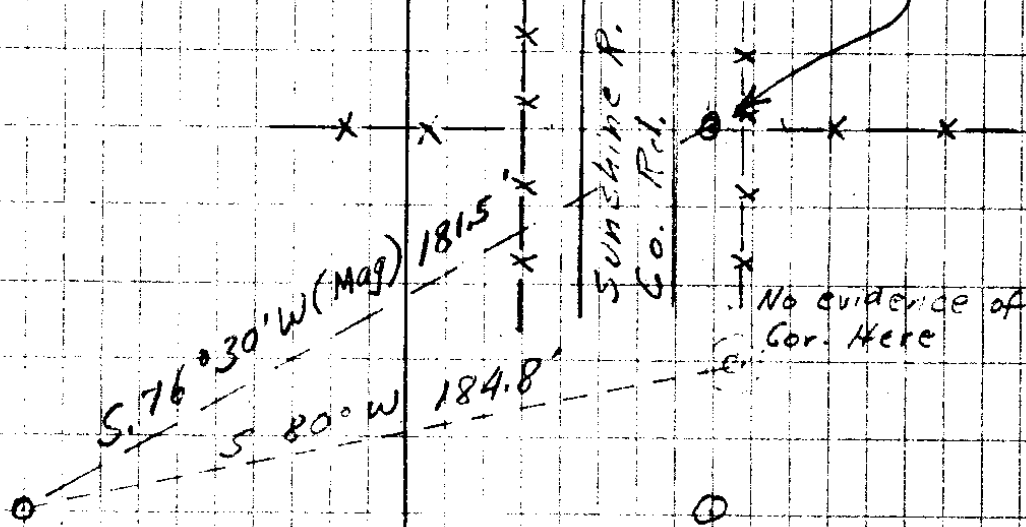

Found old stump &
roots of 10" Ash which
shows evidence of being old

bearing tree. Located near
center of creek & had been
washed out & displaced in
falling down.

Charles S. Collins

1

N.E. Cor. S. Harkness: DLC 41. T275., R5W

Evidence of old DLG Cor.
used in survey of 1 Acre
tract W.E. Gerretson purchased
from Carl Roslyn