


SEC. 11 T275., R3W WM.

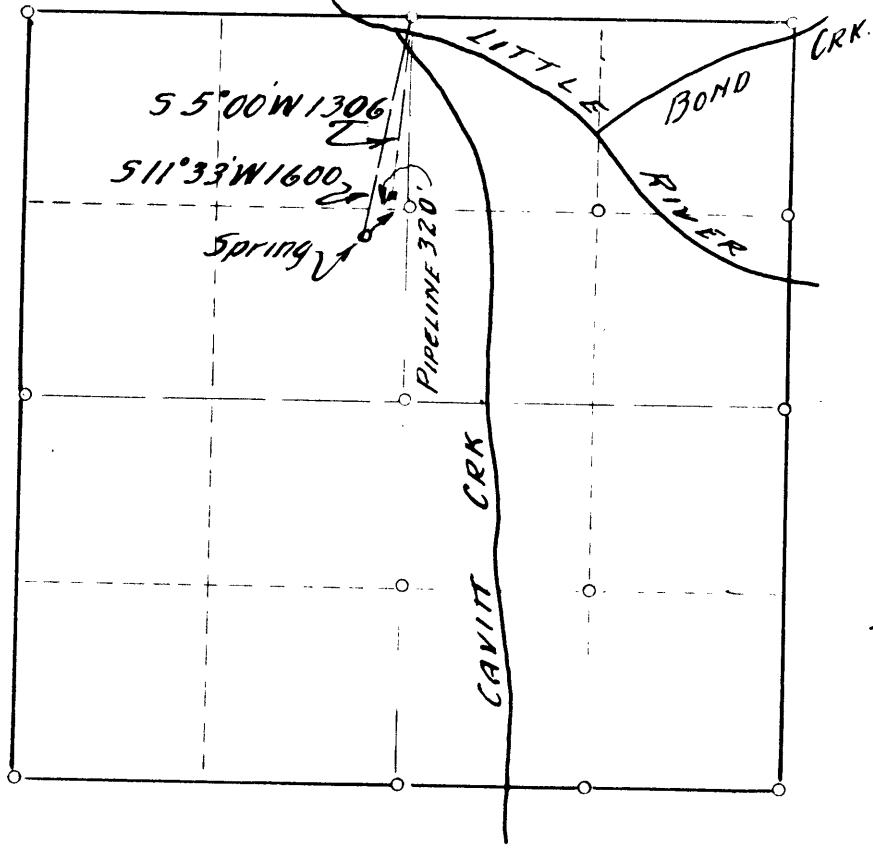

DOMESTIC WATER SYSTEM  
J. F. SOWERS  
GLIDE OREGON

COUNTY SURVEYOR'S OFFICE  
DOUGLAS COUNTY OREGON

I, BEN. B IRVING of ROSEBURG, OREGON, do hereby Certify that this map was made from notes taken during an actual survey made by me on APRIL 26 1945 and that it correctly represents the works described in the accompanying application together with the location of streams and other ditches in the immediate vicinity

*Ben B. Irving*  
REGISTERED PROFESSIONAL  
ENGINEER.

OREGON No. 240  
Nov 8, 1919