


C.S. FILE 30/240153/49  
M19-20

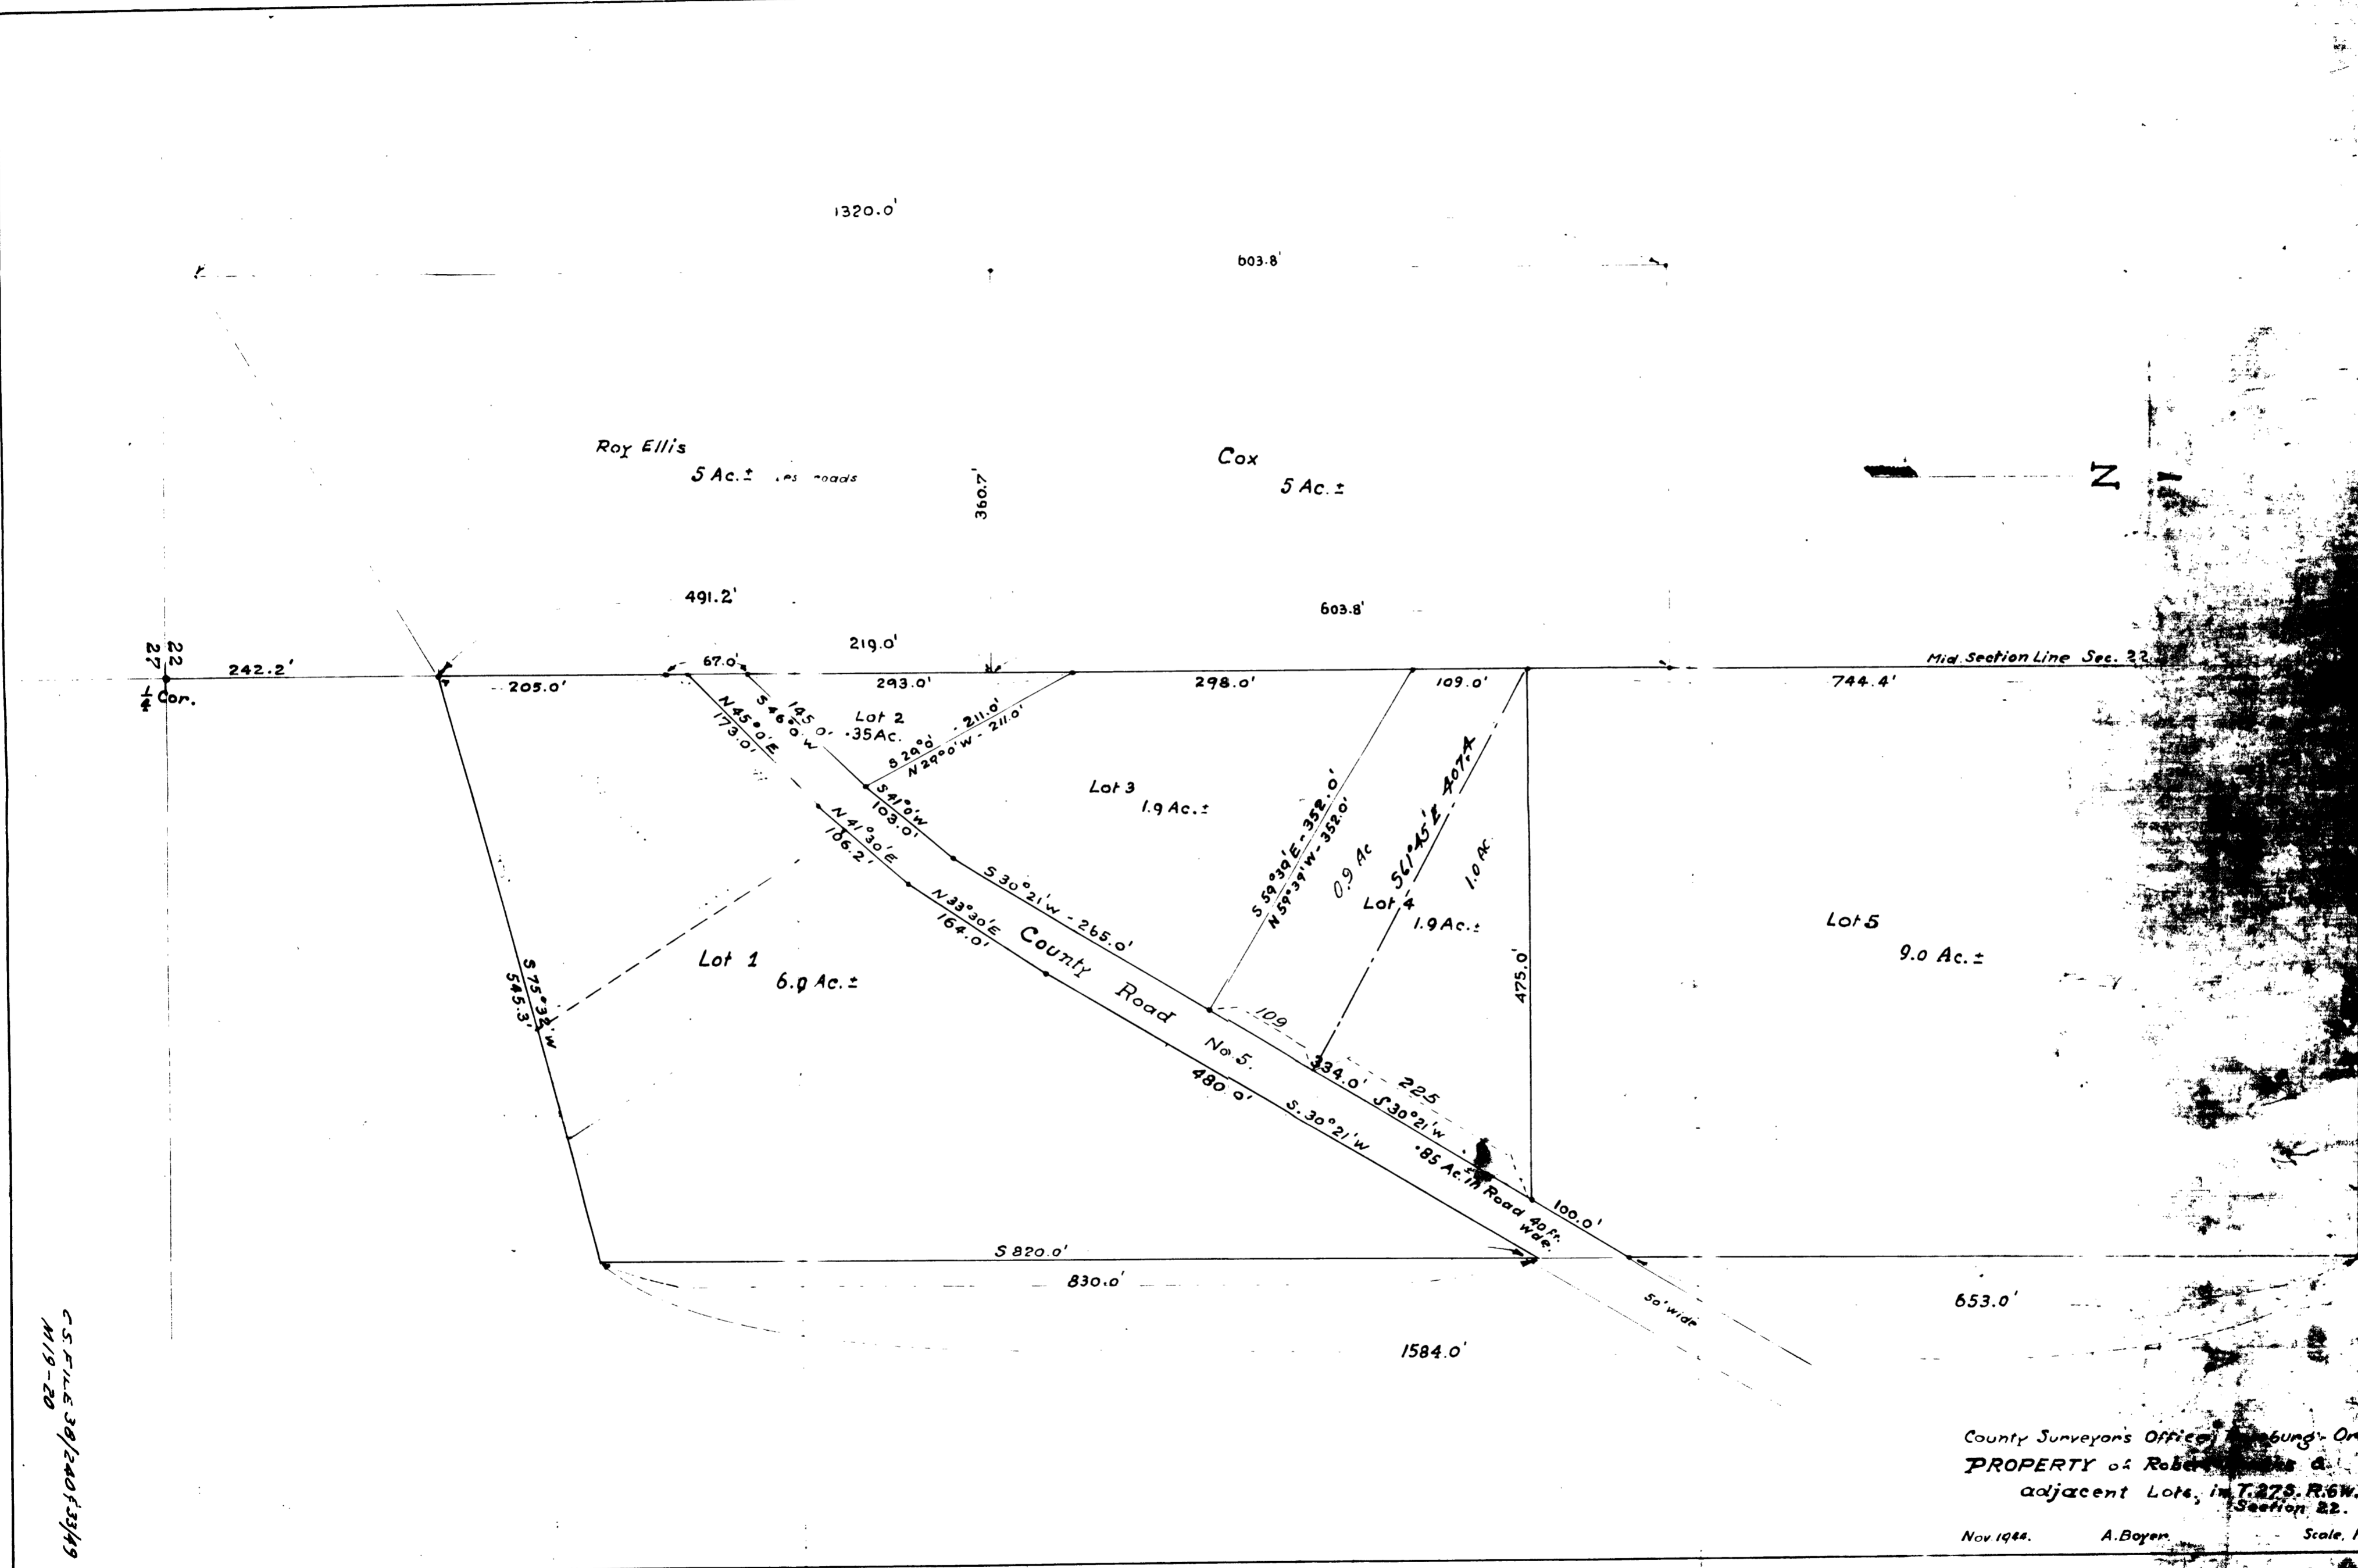

C.S. FILE 30/240153/49  
M19-20

County Surveyors Office, Hamburg, One  
**PROPERTY of Robert [Name] &**  
 adjacent Lots, in T.27S. R.6W. N.M.  
 Section 22.  
 Nov 1944. A. Boyer. Scale, 1" = 100'