

21.22  
28.27  
Axle Shaft

West 274.0 ft.

30.0  
South  
Iron Bolt

30.0

OAK

ST.


ST.

ST.

COUNTY SURVEYOR'S OFFICE  
DOUGLAS COUNTY OREGON  
SURVEY OF BLOCKS 5 AND 8  
MYRTLE CREEK

Scale 1" = 50 ft. Feb. 18, 1946

COUNTY SURVEYORS FILE DATA  
DO NOT REMOVE FROM OFFICE

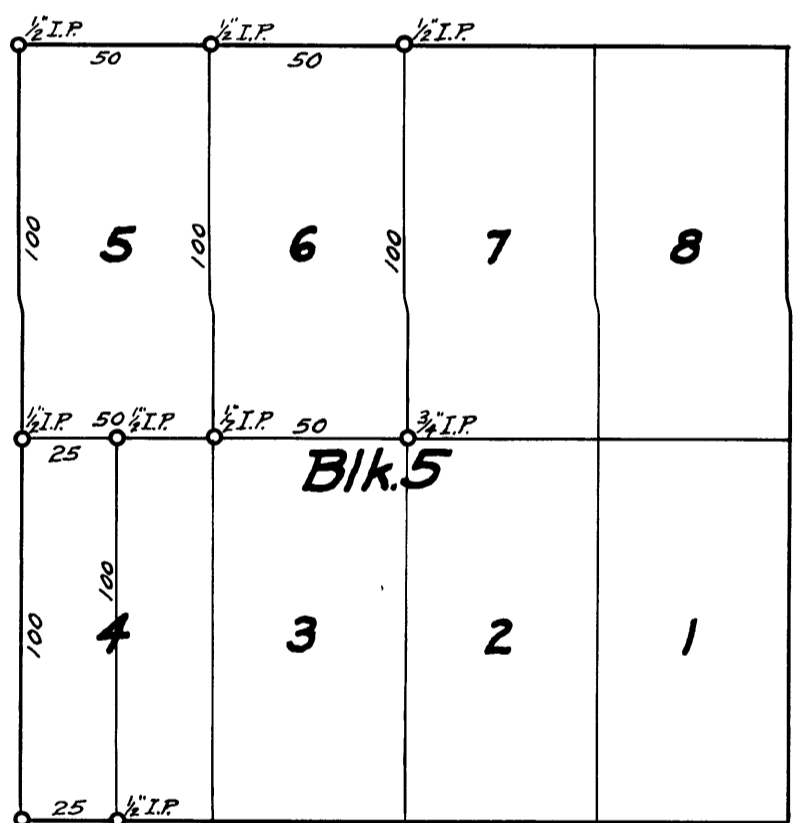


S. 43° 05' W. 1030.0 ft.

MAIN

ST.

THIRD

SECOND

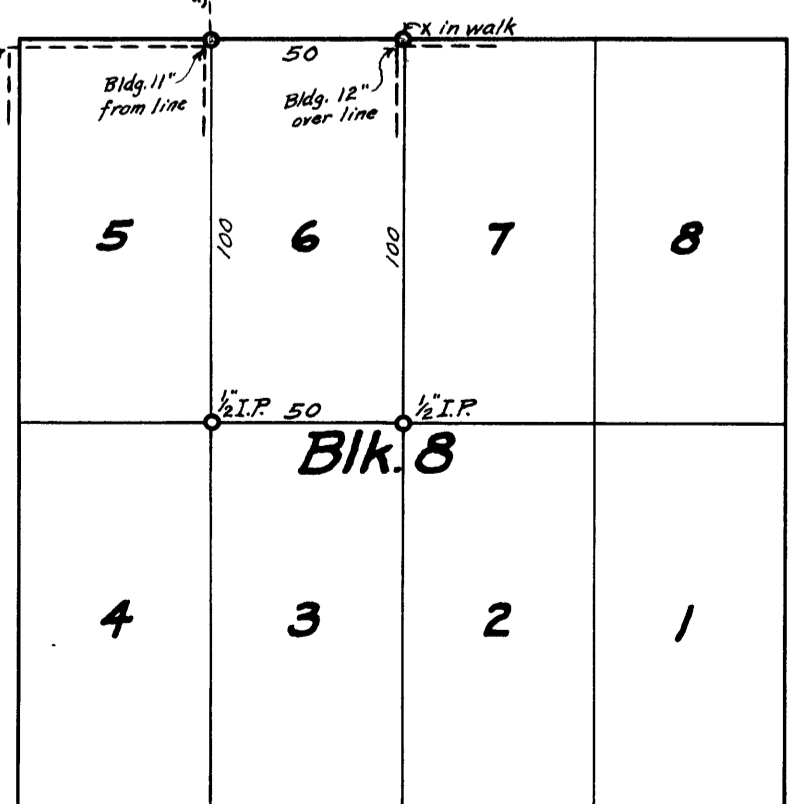

REGISTERED  
OREGON  
LAND SURVEYOR

Geo. J. Wenderoth

MARCH 18, 1944  
George J. Wenderoth  
5